


1c-20-230(15)  
 1-20-15  
 Std. Show  
 PL 20(15)  
 F. 20-230  
 R.R.S.

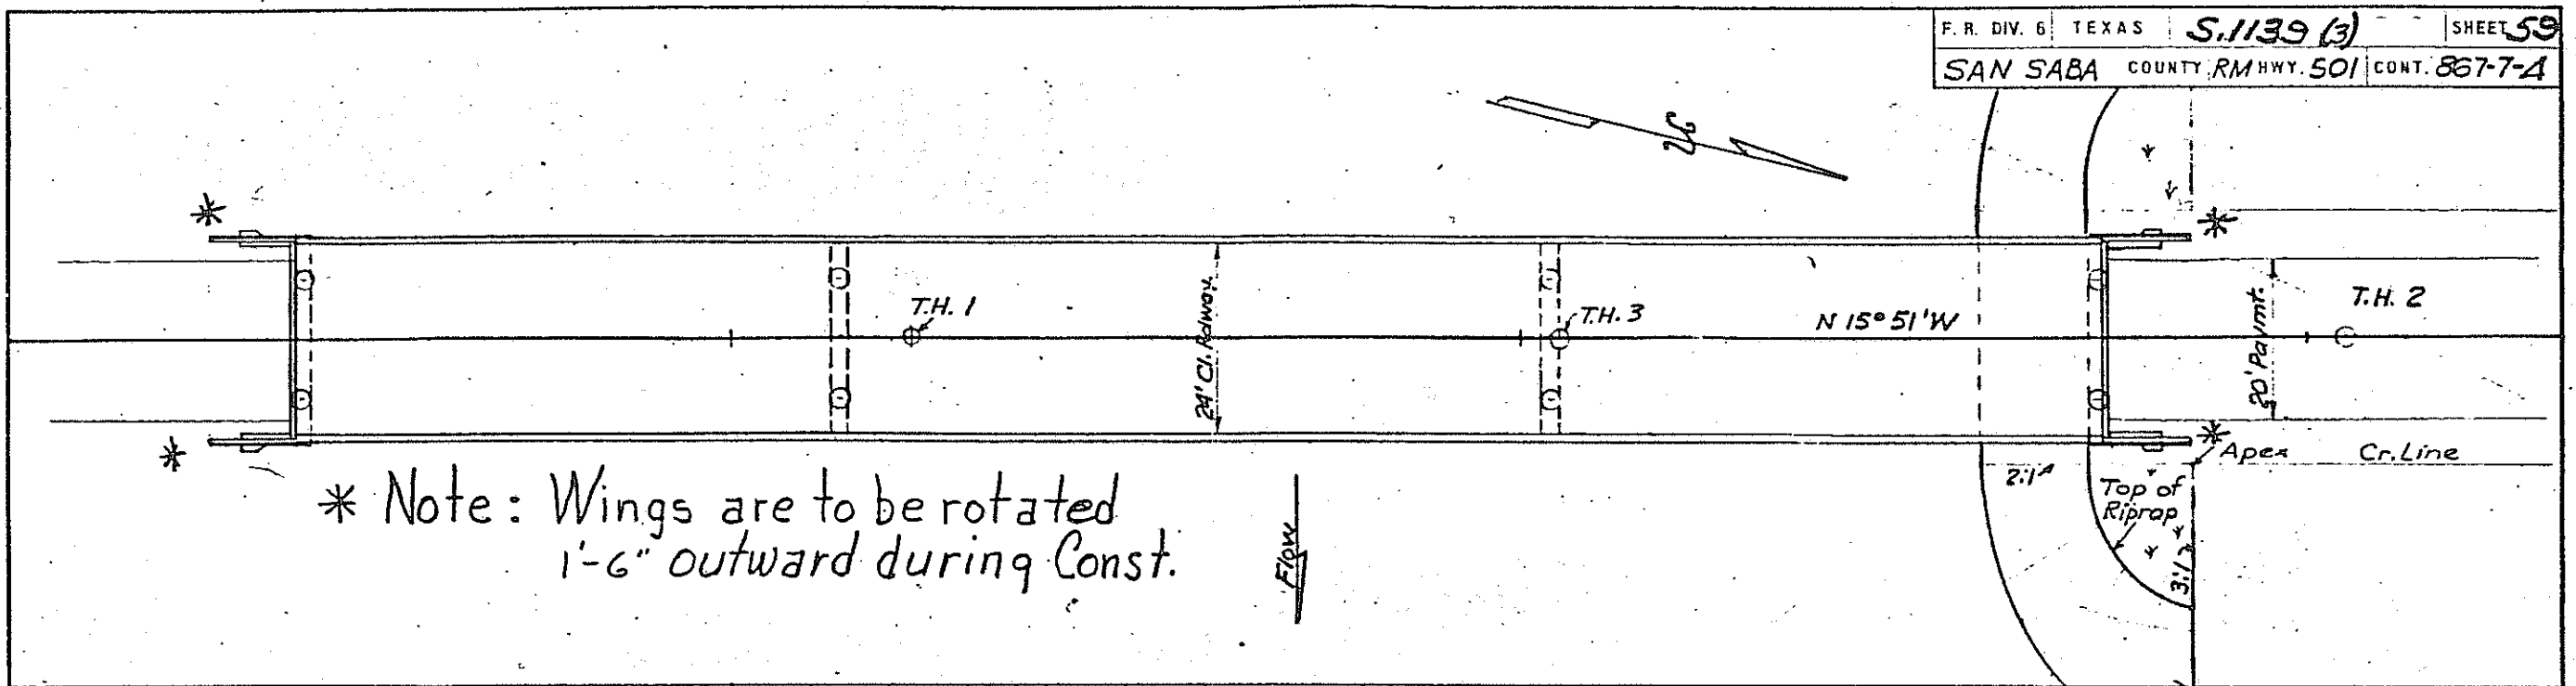

\* Note: Wings are to be rotated  
 1'-6" outward during Const.

