

NOTE: The Contractor will be permitted to excavate a work channel in the construction of this project, subject to the following limitations: No portion of the work channel shall be within fifteen feet of the closest portion of the substructure shall be excavated to an elevation below the elevation of the bottom of the adjacent footing. Before completion of the construction of the project the contractor will be required to backfill the work channel to the approximate natural ground line for a distance of 50 feet from the centerline of the roadway. Mooring of work barges or other equipment to the completed or partially completed substructure, or contact between mooring lines and substructure will not be permitted.

All elevations are based on Mean Low Tide Datum which is 1.0' below Mean Sea Level Datum.

Hole No. 2
Sta 68+00



ESTIMATED QUANTITIES

Struct. Excav. C.Y.	Class A Conc.		Reinf. Steel Lb.	Struct. Steel Lb.	Type C. Fresh. Bms. L.F.	16" Precast Conc. Fining L.F.	No. Precast Conc. Test Piles L.F.	Aluminum Rolling		Class E Conc. Cap. C.Y.	Class B Conc. Rip. C.Y.	Nov. Lights L.S.	Trkd. Timber FBM L.F.	Timbr. Piling L.F.	
	Slabs C.Y.	Bents C.Y.						Ty. "P" L.F.	Ty. "T" L.F.						
Abutment Bents 1+36	60.0	29.6	4544			760									
Int. Bents 6-7 + 30-35	296.0	417.0	63492			3870	190								
Int. Bents 8-16 + 21-29	596.0	992.4	141,222			7480	190								
Transition Bents 11+20	58.0	150.3	23,726			1152									
Piers 18 + 19	420.0	278.0	37,816			2,070	100			117.0					
32-53' Simple Spans	1443.8		281,288	8262	6666.67			1696	1696						
1-400' R. Girder Unit	313.0		62,270	456,700				400	400						
Fender System				2250								15550	5200		
Navigation Lights															
Total	1,430	1,736.8	1,867.8	614,358	466,512	6666.67	15,332	480	2,096	2,096	117.0	11,800	1	15,550	5,200


Penetrometer Notes

Standard Penetrometer Test (3" Diameter Steel Pin with Conical Point). Explanation of fractional numbers shown on Test Hole Data: 50(18) ; 50 = No. of blows required to drive pin 18" with 170# hammer dropped 2' 0"

22/40 ; 22 = No. of blows required to drive pin first 6" ; 40 = No. of blows required to drive pin second 6"

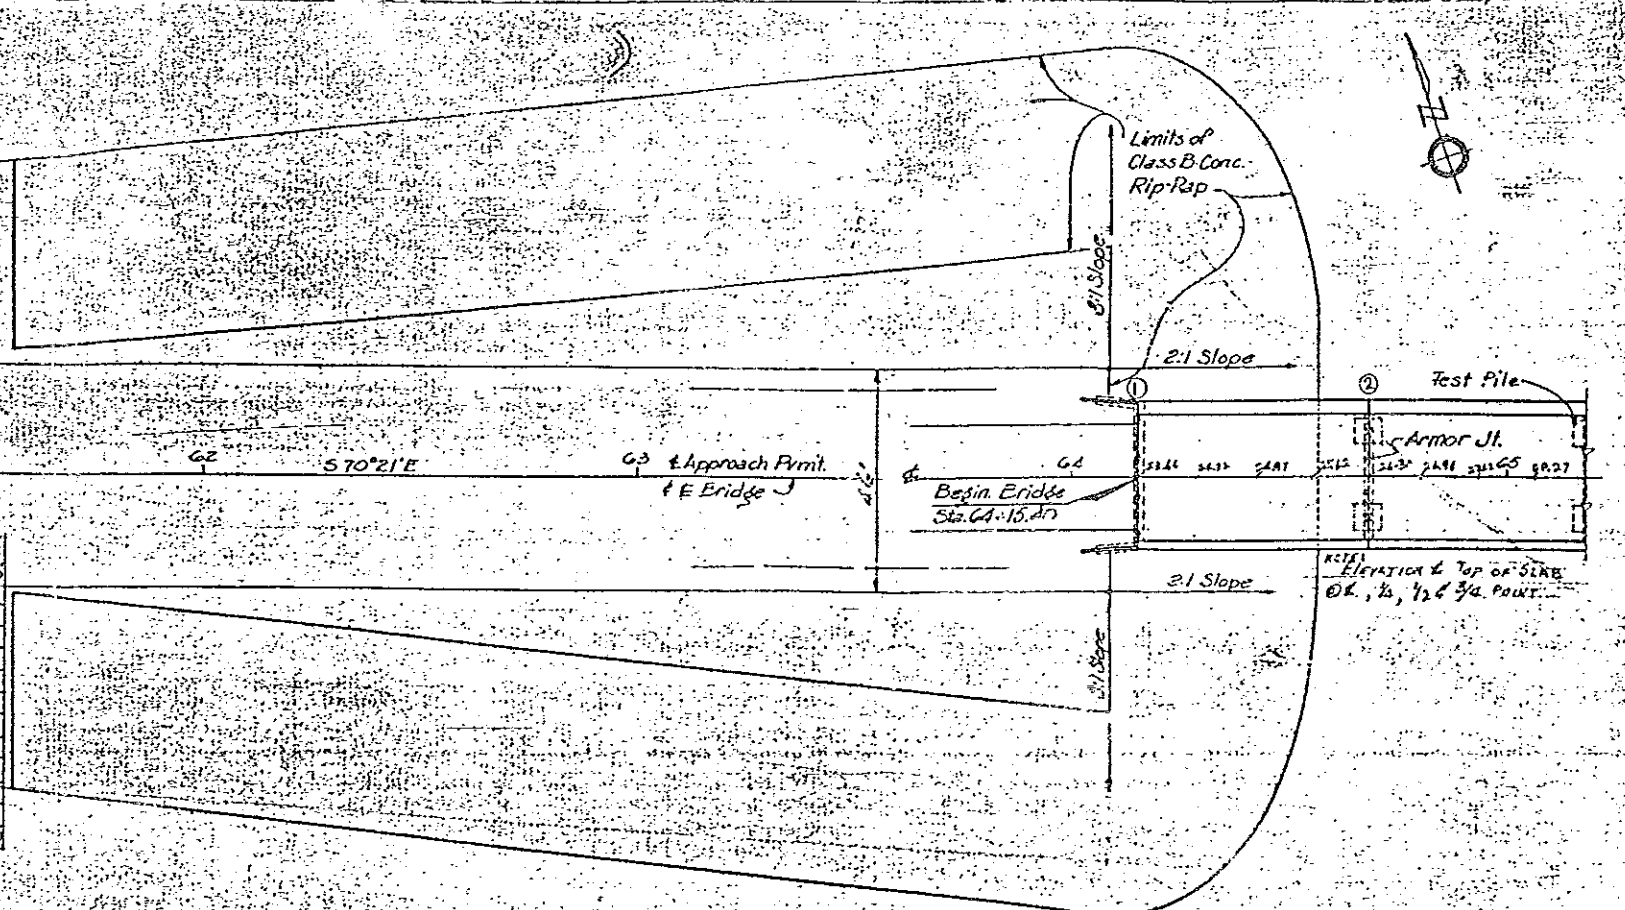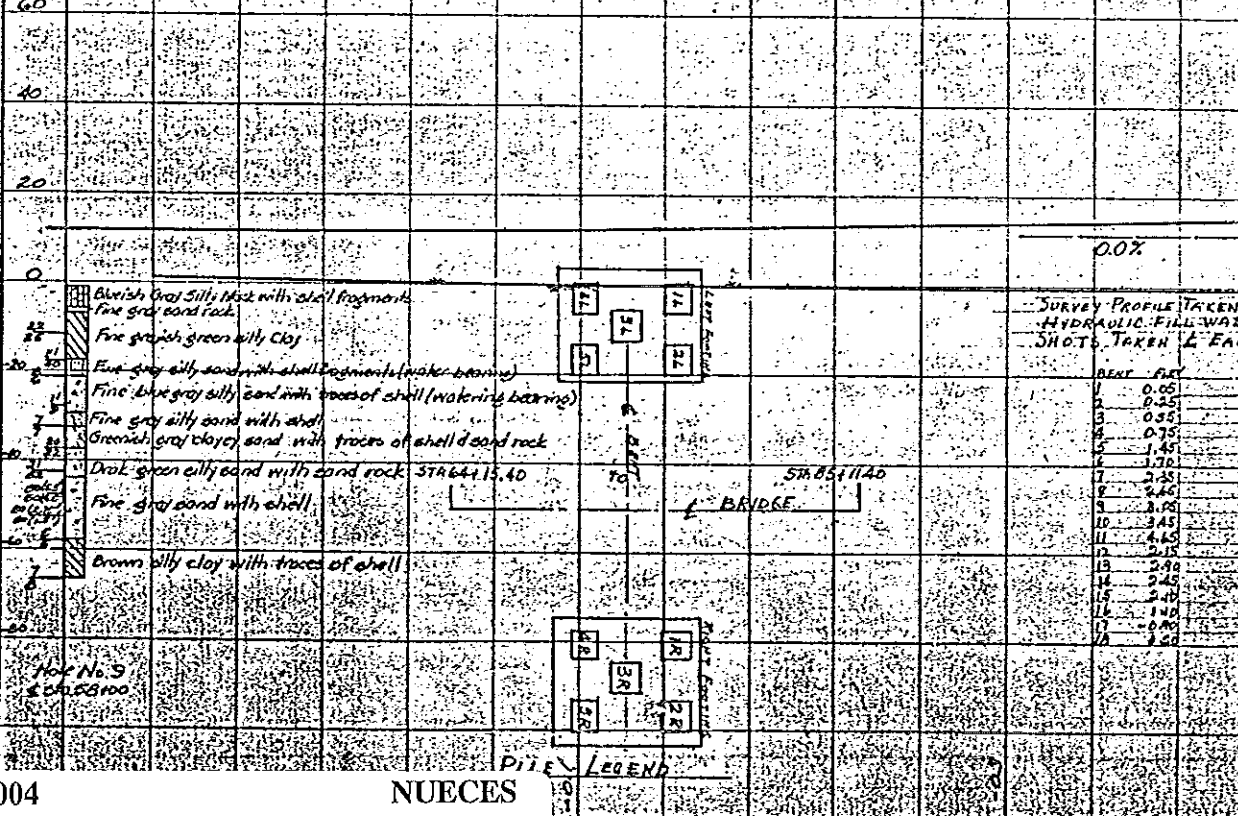

Note: Embankment for bridge approaches to be constructed by others under contract to be awarded by Texas Highway Department. Embankment for bridge approaches to be constructed simultaneously with construction of this project.

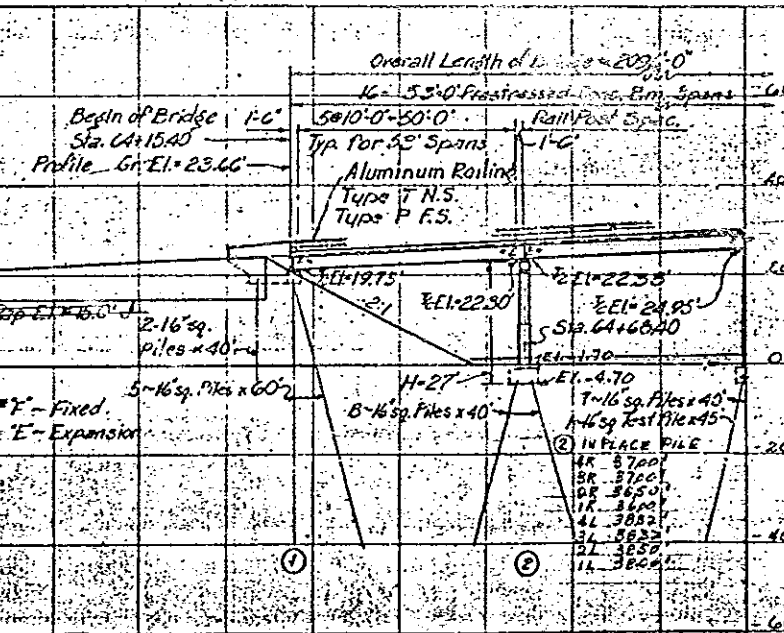

178-2263-02-004 NUECES Maint. Sec. 09 0.80 MI SE OF S COMMERCIAL ST SH 361 over GULF INTRACOASTAL WATERWAY 35 SPANS, 3-CONT STEEL PLATE GIRDER & 32-PS CONC GIRDER SPANS ON CONC CAPS, COLUMNS & PILES


CONTRACT NO. DA-41-245-CIV-ENG. 58-154

MAR. 1958

ISSUED BY THE DISTRICT ENGINEER GALVESTON DISTRICT CORPS OF ENGINEERS GALVESTON, TEXAS


AS BUILT

GALV. DIST. FILE NO. IWW 1160-599

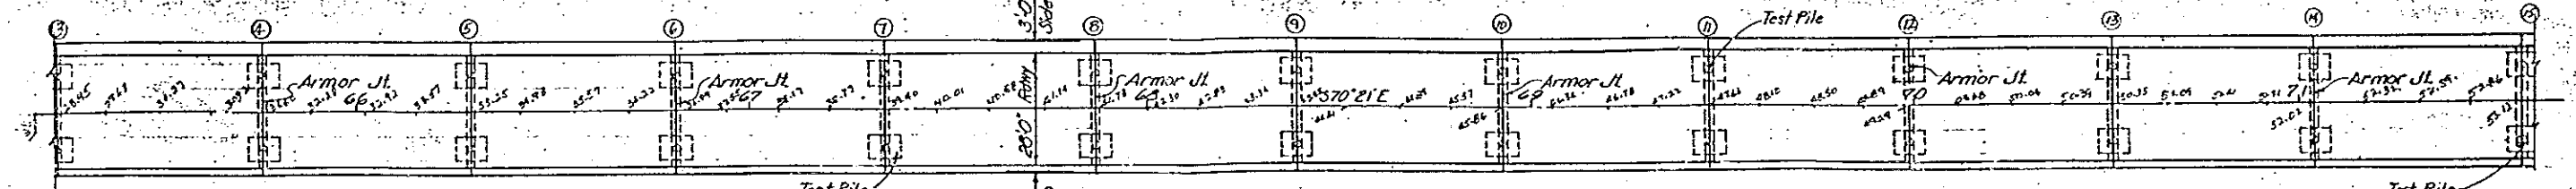

ELEVATIONS \pm AND TOP OF SLAB
@ $\frac{1}{4}$, $\frac{1}{2}$, $\frac{3}{4}$ POINTS

③ IN PLACE PILE	④ IN PLACE PILE	⑤ IN PLACE PILE	⑥ IN PLACE PILE	⑦ IN PLACE PILE	⑧ IN PLACE PILE	⑨ IN PLACE PILE	⑩ IN PLACE PILE	⑪ IN PLACE PILE	⑫ IN PLACE PILE	⑬ IN PLACE PILE	⑭ IN PLACE PILE	⑮ IN PLACE PILE
3R 40.00' 3L 40.00' 4R 40.00' 4L 40.00' 5R 40.00' 5L 40.00' 6R 40.00' 6L 40.00' 7R 40.00' 7L 40.00' 8R 40.00' 8L 40.00' 9R 40.00' 9L 40.00' 10R 40.00' 10L 40.00' 11R 40.00' 11L 40.00' 12R 40.00' 12L 40.00' 13R 40.00' 13L 40.00' 14R 40.00' 14L 40.00'	4R 40.00' 4L 40.00' 5R 40.00' 5L 40.00' 6R 40.00' 6L 40.00' 7R 40.00' 7L 40.00' 8R 40.00' 8L 40.00' 9R 40.00' 9L 40.00' 10R 40.00' 10L 40.00' 11R 40.00' 11L 40.00' 12R 40.00' 12L 40.00' 13R 40.00' 13L 40.00' 14R 40.00' 14L 40.00'	5R 39.77' 5L 39.77' 6R 39.09' 6L 39.09' 7R 38.41' 7L 38.41' 8R 40.00' 8L 40.00' 9R 40.00' 9L 40.00' 10R 40.00' 10L 40.00'	6R 40.00' 6L 40.00' 7R 40.00' 7L 40.00' 8R 40.00' 8L 40.00' 9R 40.00' 9L 40.00' 10R 40.00' 10L 40.00'	7R 40.00' 7L 40.00' 8R 40.00' 8L 40.00' 9R 40.00' 9L 40.00' 10R 40.00' 10L 40.00'	8R 40.00' 8L 40.00' 9R 40.00' 9L 40.00' 10R 40.00' 10L 40.00'	9R 40.00' 9L 40.00' 10R 40.00' 10L 40.00'	10R 40.00' 10L 40.00' 11R 40.00' 11L 40.00'	11R 40.00' 11L 40.00' 12R 40.00' 12L 40.00'	12R 40.00' 12L 40.00' 13R 40.00' 13L 40.00'	13R 40.00' 13L 40.00' 14R 40.00' 14L 40.00'	14R 40.00' 14L 40.00'	15R 40.00' 15L 40.00'

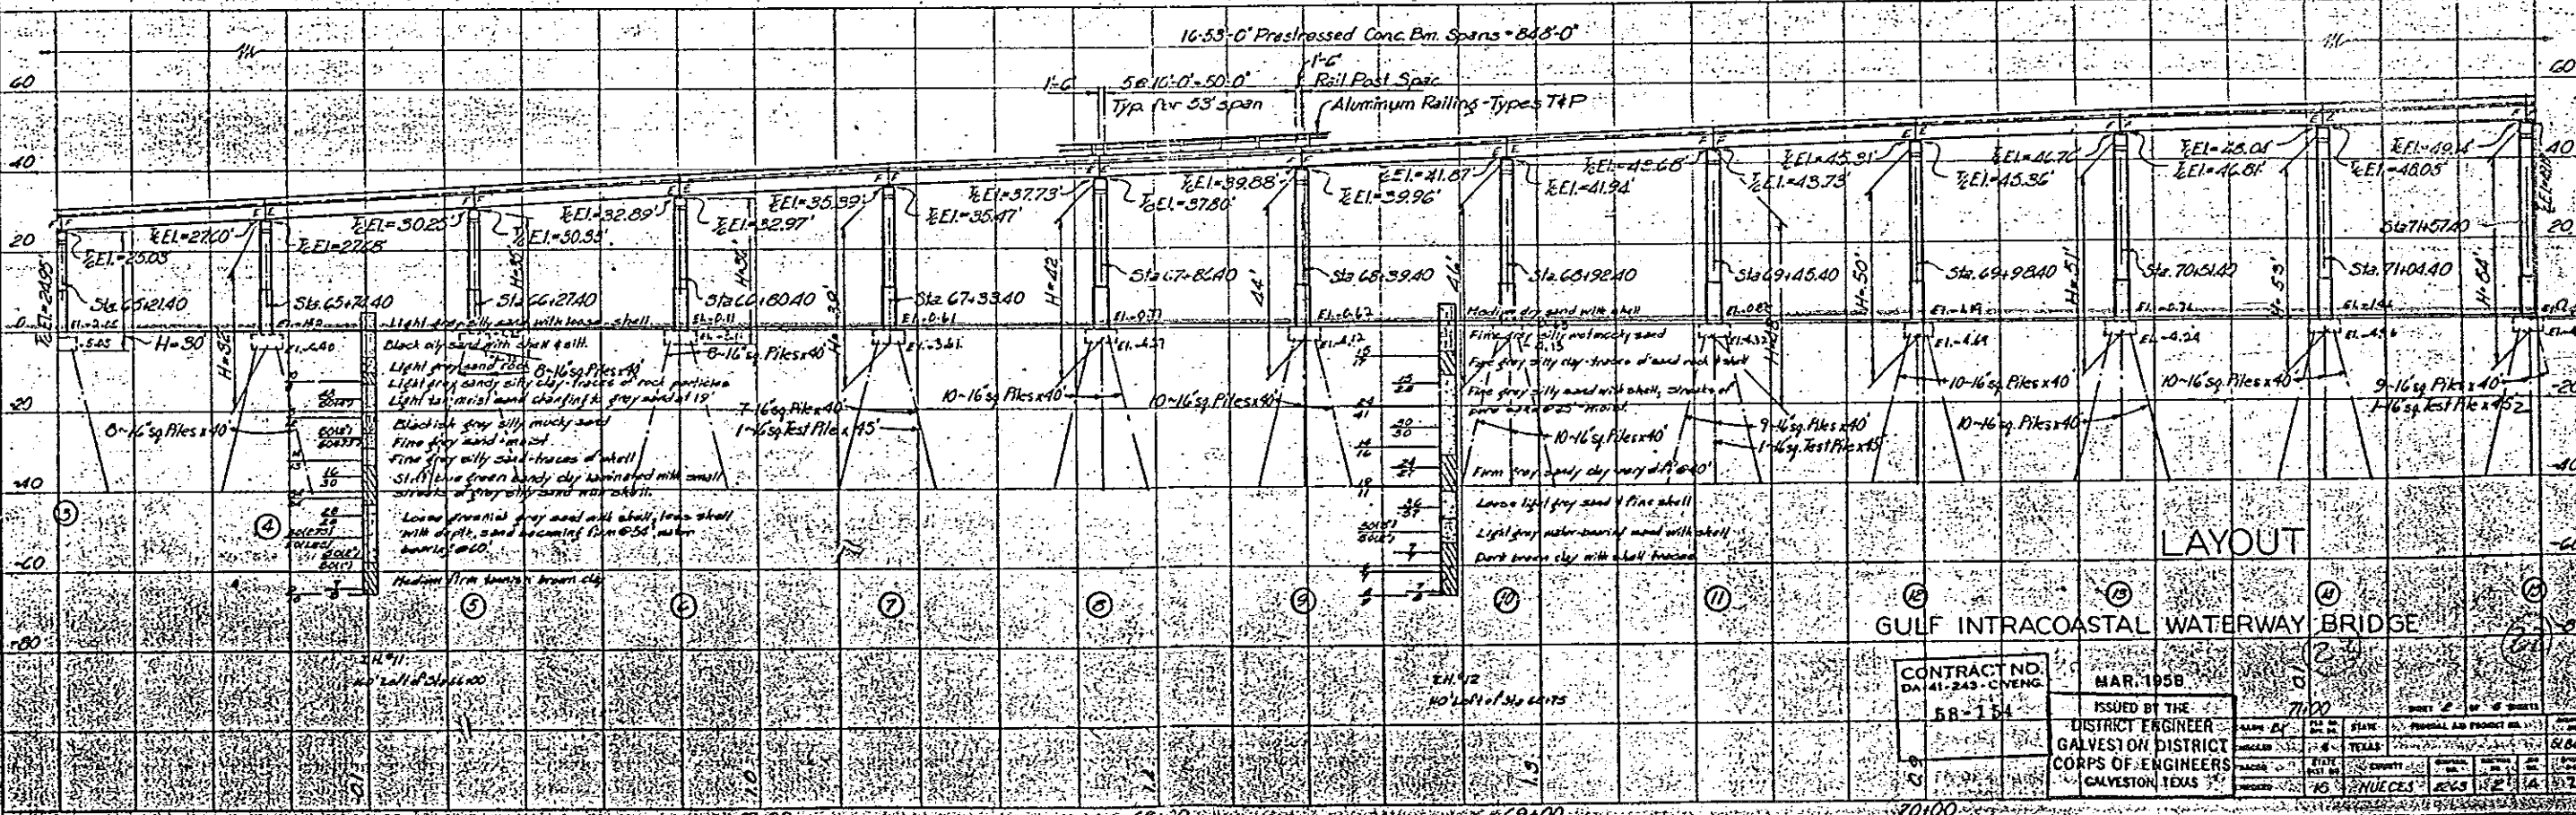



LAYOUT

GULF INTRACOASTAL WATERWAY BRIDGE

CONTRACT NO. DA 41-243-CV-ENG 58-154	MAR. 1958	ISSUED BY THE DISTRICT ENGINEER GALVESTON DISTRICT CORPS OF ENGINEERS GALVESTON, TEXAS	7100	7100
--	-----------	--	------	------


AS BUILT

GALV. DIST. FILE NO. IWW 4150-599

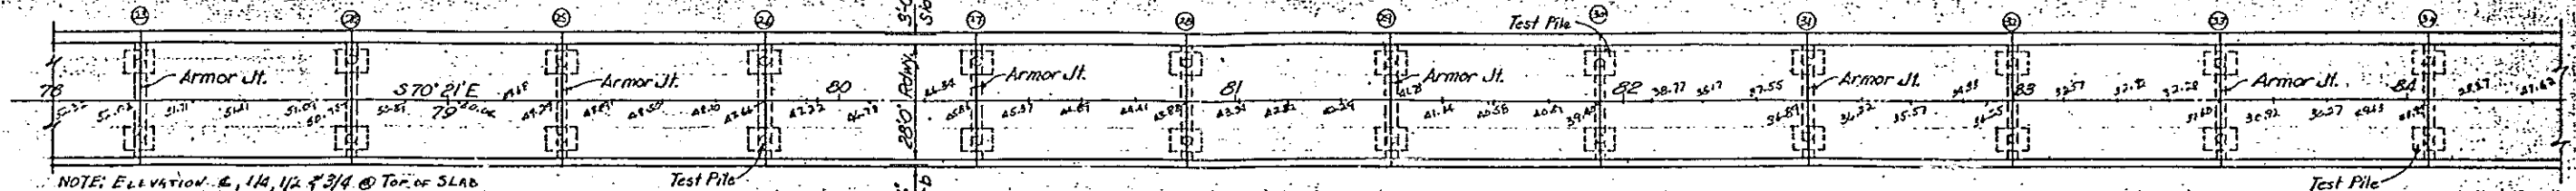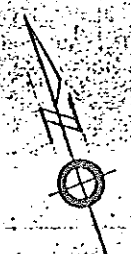

NOTE: ELEVATION $\frac{1}{4}$, $\frac{1}{2}$, & $\frac{3}{4}$ @ Top of Slab

IN PLACE PILE	IN PLACE PILE	IN PLACE PILE	IN PLACE PILE	IN PLACE PILE	IN PLACE PILE	IN PLACE PILE	IN PLACE PILE	IN PLACE PILE	IN PLACE PILE	IN PLACE PILE	IN PLACE PILE
2R-45.00'	2R-45.00'	2R-45.00'	2R-45.00'	2R-45.00'	2R-45.00'	2R-45.00'	2R-45.00'	2R-45.00'	2R-45.00'	2R-45.00'	2R-45.00'
1R-45.00'	1R-45.00'	1R-45.00'	1R-45.00'	1R-45.00'	1R-45.00'	1R-45.00'	1R-45.00'	1R-45.00'	1R-45.00'	1R-45.00'	1R-45.00'
4R-45.00'	4R-45.00'	4R-45.00'	4R-45.00'	4R-45.00'	4R-45.00'	4R-45.00'	4R-45.00'	4R-45.00'	4R-45.00'	4R-45.00'	4R-45.00'
3R-45.00'	3R-45.00'	3R-45.00'	3R-45.00'	3R-45.00'	3R-45.00'	3R-45.00'	3R-45.00'	3R-45.00'	3R-45.00'	3R-45.00'	3R-45.00'
2L-45.00'	2L-45.00'	2L-45.00'	2L-45.00'	2L-45.00'	2L-45.00'	2L-45.00'	2L-45.00'	2L-45.00'	2L-45.00'	2L-45.00'	2L-45.00'
1L-45.00'	1L-45.00'	1L-45.00'	1L-45.00'	1L-45.00'	1L-45.00'	1L-45.00'	1L-45.00'	1L-45.00'	1L-45.00'	1L-45.00'	1L-45.00'
4L-45.00'	4L-45.00'	4L-45.00'	4L-45.00'	4L-45.00'	4L-45.00'	4L-45.00'	4L-45.00'	4L-45.00'	4L-45.00'	4L-45.00'	4L-45.00'
3L-45.00'	3L-45.00'	3L-45.00'	3L-45.00'	3L-45.00'	3L-45.00'	3L-45.00'	3L-45.00'	3L-45.00'	3L-45.00'	3L-45.00'	3L-45.00'

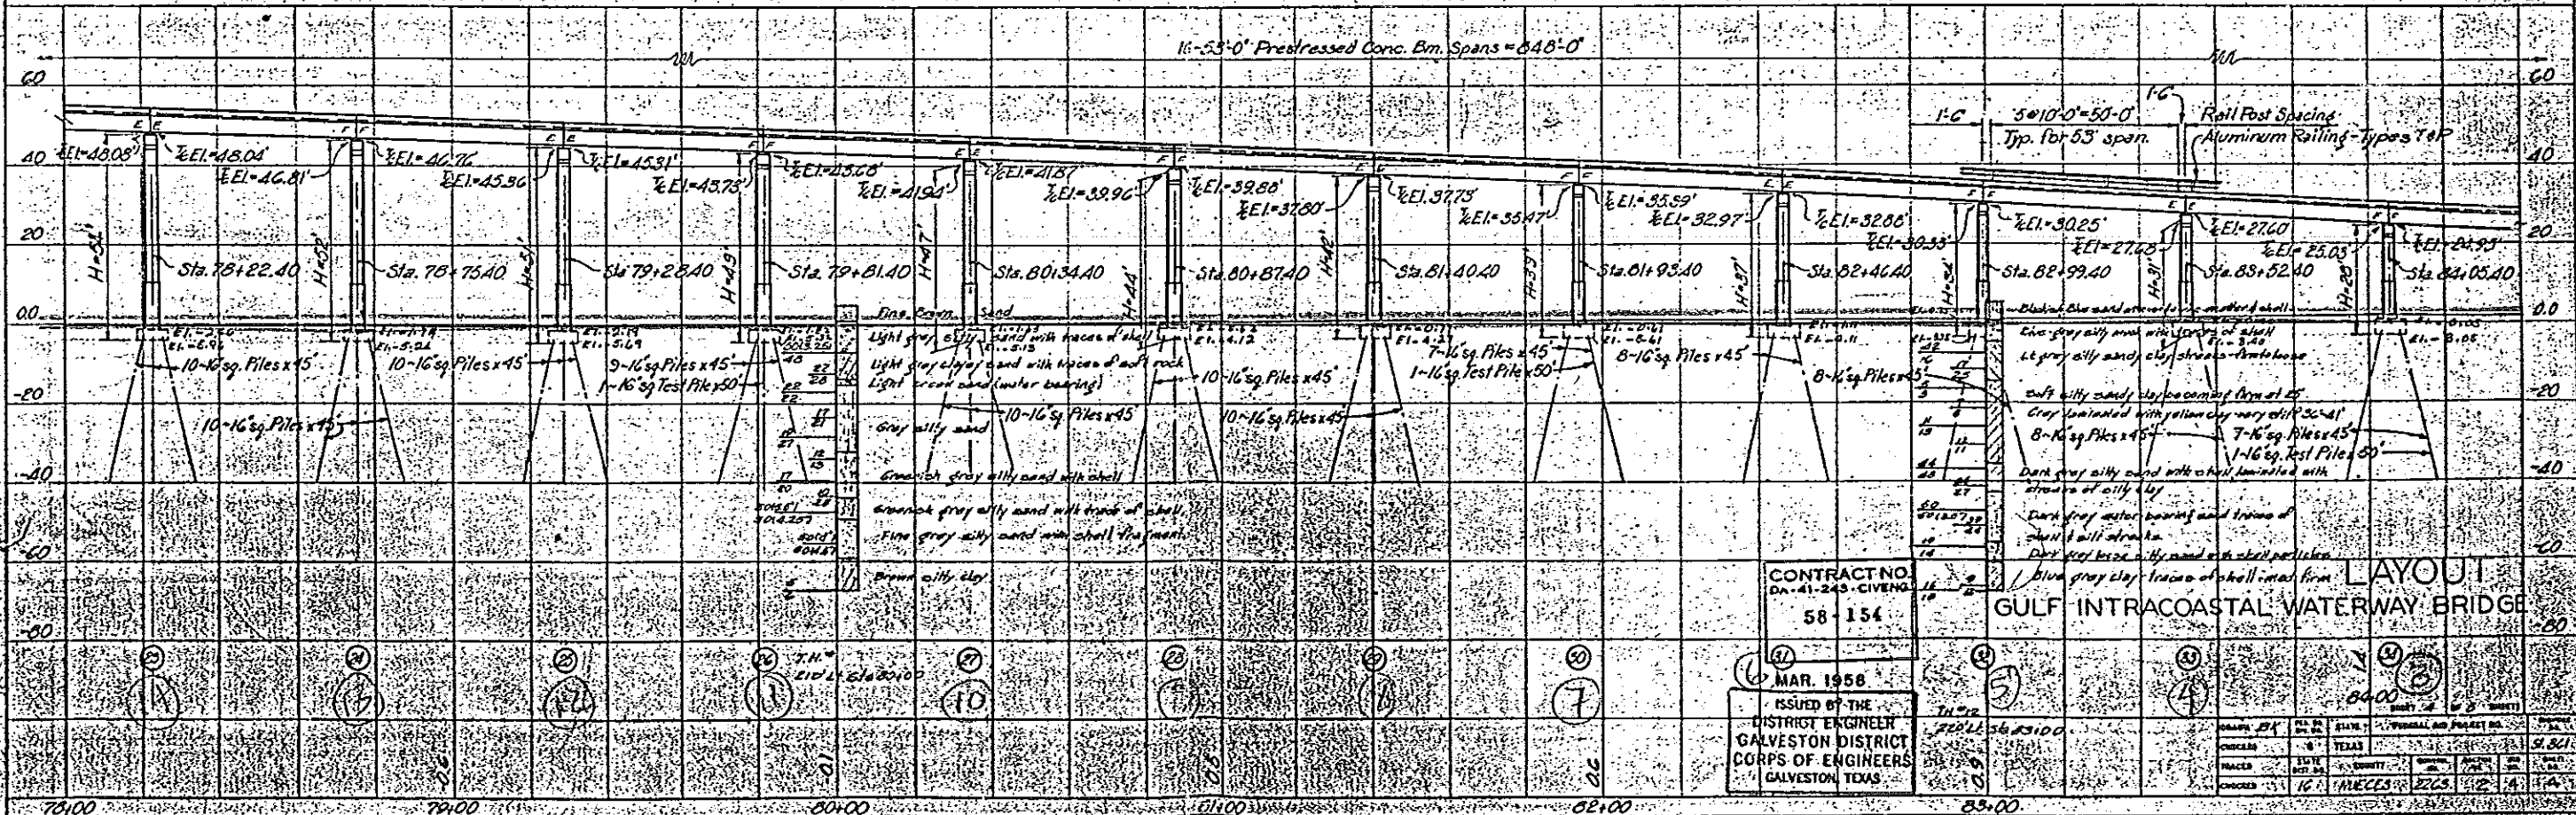

CONTRACT NO. DA-41-243-CIVENG 58-154


MAR. 1958
ISSUED BY THE DISTRICT ENGINEER GALVESTON DISTRICT CORPS OF ENGINEERS GALVESTON, TEXAS

LAYOUT GULF INTRACOASTAL WATERWAY BRIDGE


NO.	DATE	BY	REVISION
1			
2			
3			
4			
5			



87

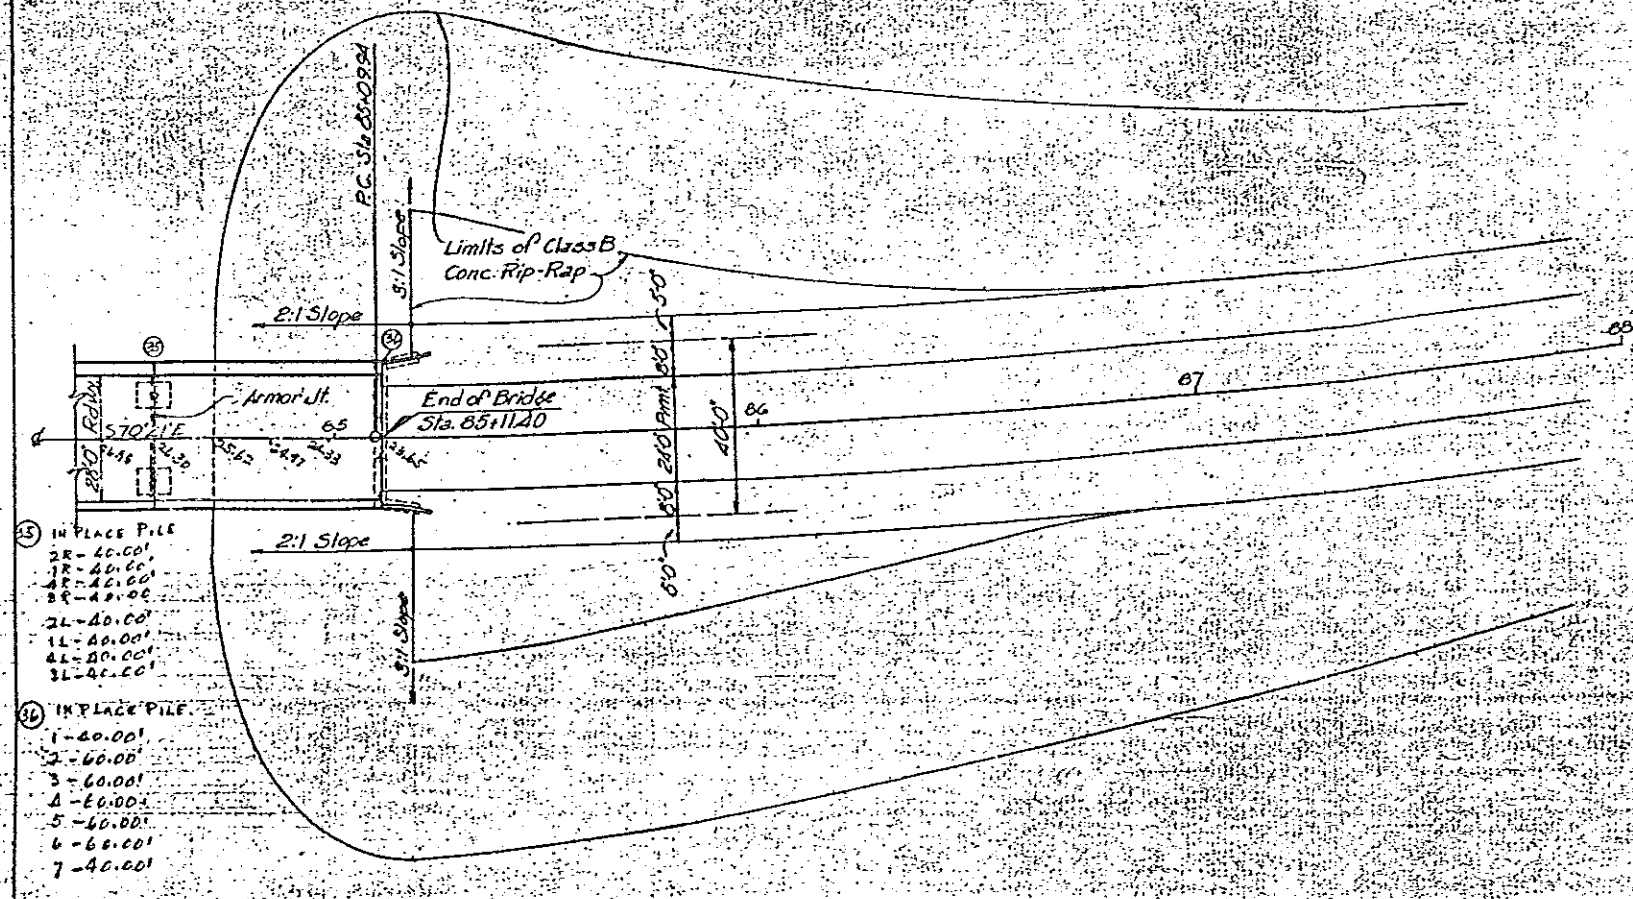

- ③ IN PLACE PILE
 - 2R - 40.00'
 - 1R - 40.00'
 - 4R - 40.00'
 - 8R - 40.00'
 - 2L - 40.00'
 - 1L - 40.00'
 - 4L - 40.00'
 - 3L - 40.00'
- ④ IN PLACE PILE
 - 1 - 40.00'
 - 2 - 60.00'
 - 3 - 60.00'
 - 4 - 60.00'
 - 5 - 60.00'
 - 6 - 60.00'
 - 7 - 40.00'

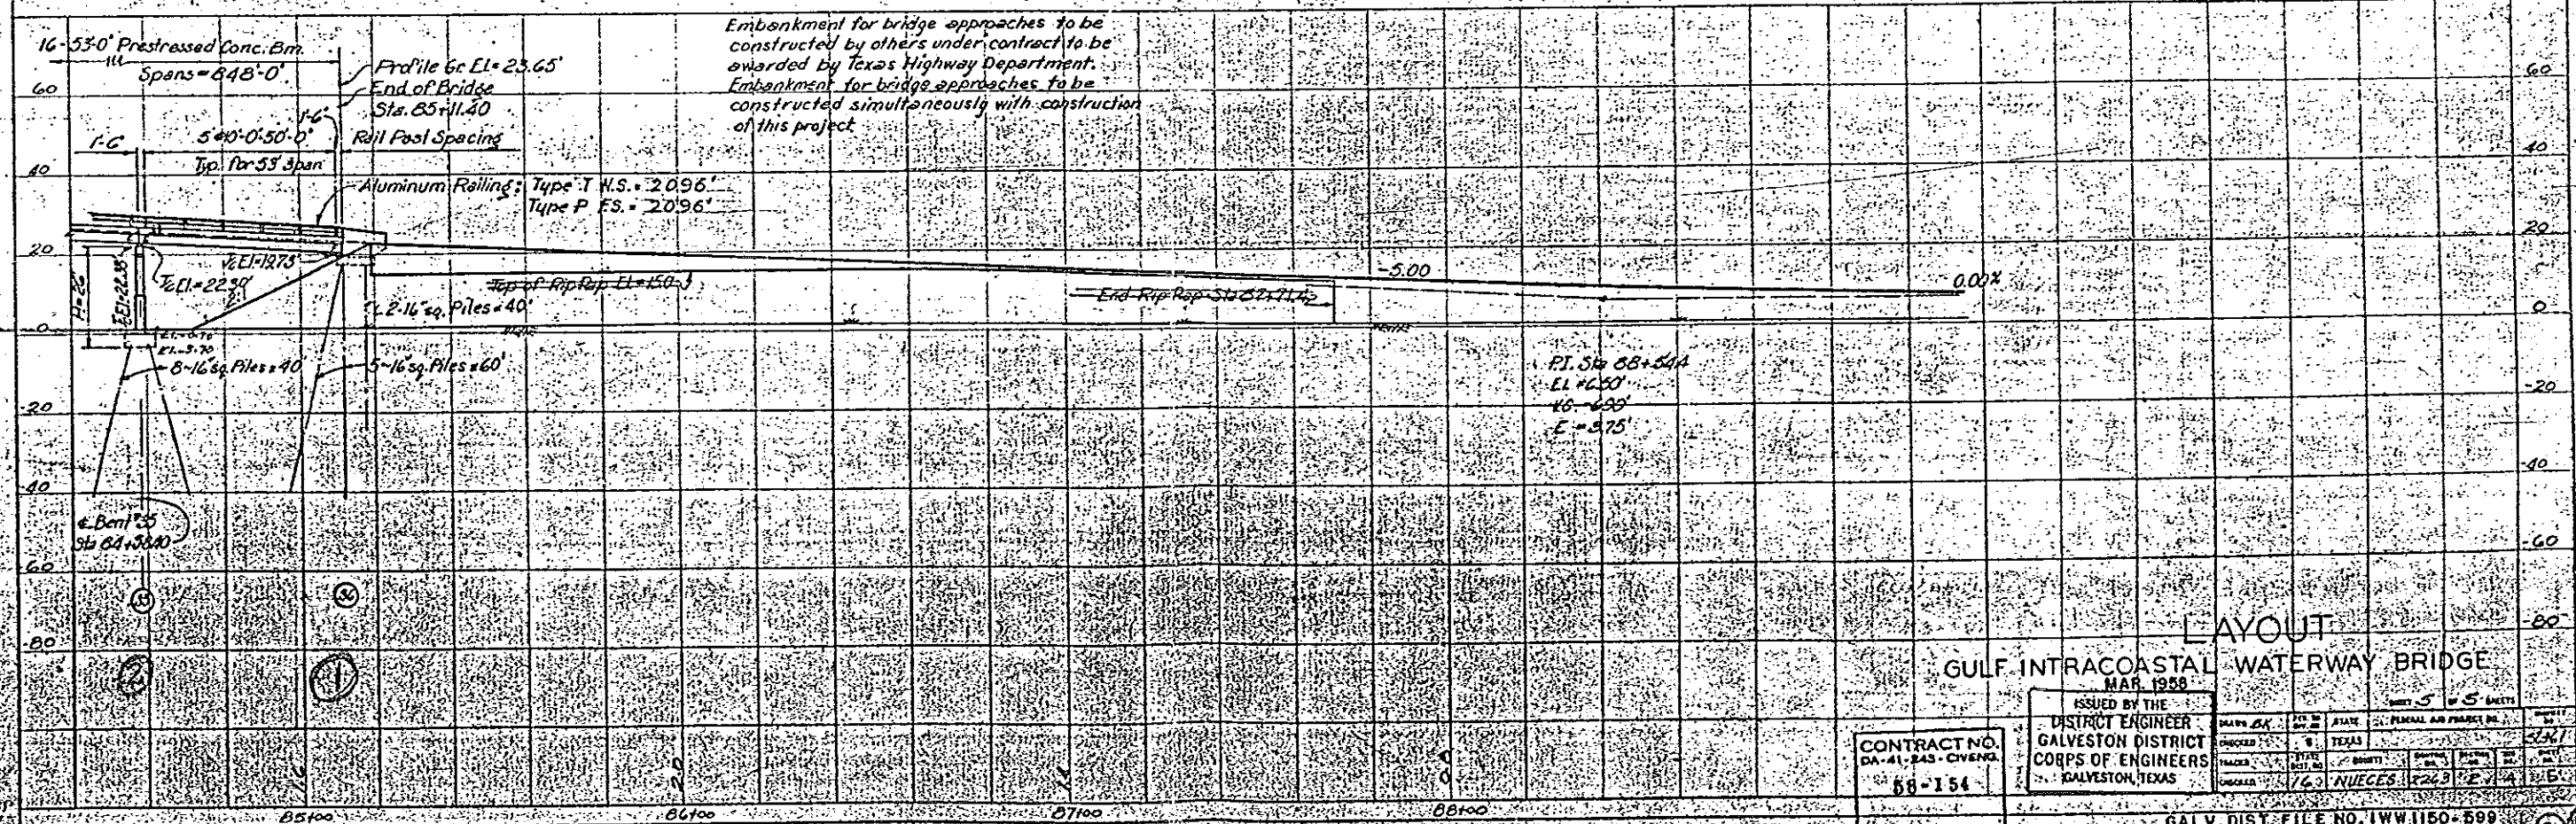


LAYOUT
GULF INTRACOASTAL WATERWAY BRIDGE
MAR. 1958

ISSUED BY THE DISTRICT ENGINEER GALVESTON DISTRICT CORPS OF ENGINEERS GALVESTON, TEXAS

DESIGNED BY	STATE	PROJECT NO.	DATE
CHECKED BY	TEXAS	12261	
DRAWN BY	PROJECT	12261	
CHECKED BY	NO. 3	NO. 2	


CONTRACT NO. DA-41-243-CV-804
58-154

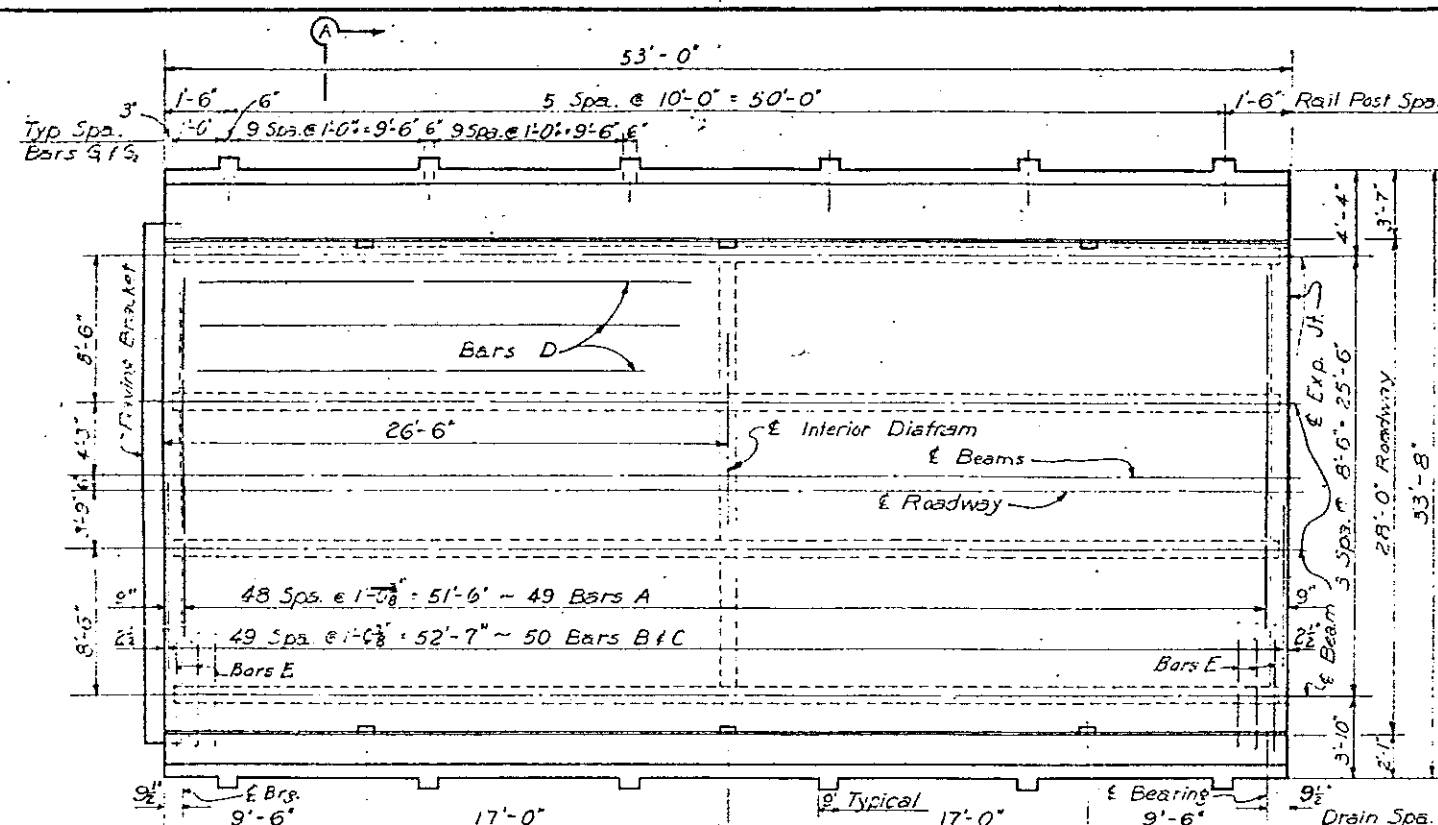


Note: See Railing Sheet for Railing Details.

Note: Omit drains over header banks.


PLAN
Note: Plan shown is for end span. Interior span details are similar. For location of armor joints, see Layout.

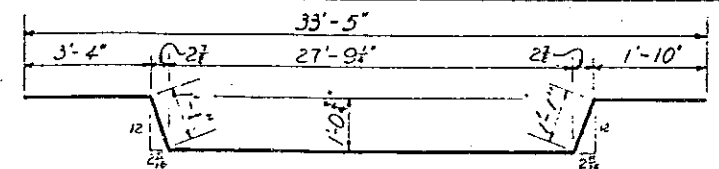

BARS C

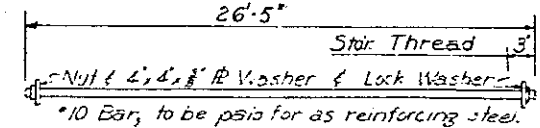

BARS H

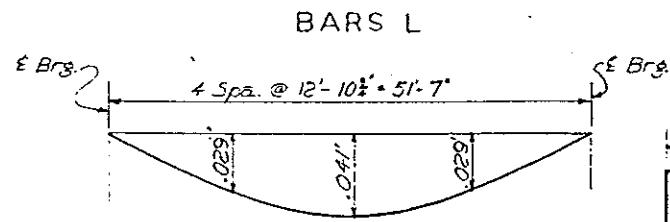


BARS L


BARS J

BARS G


BARS N

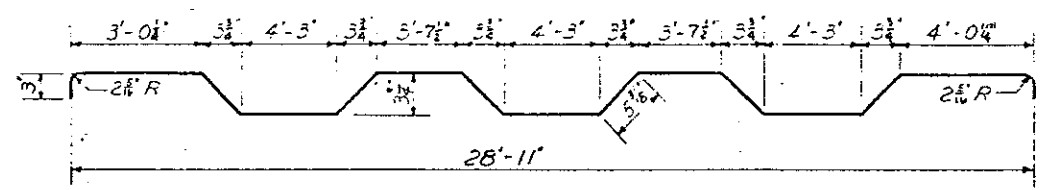

BARS A

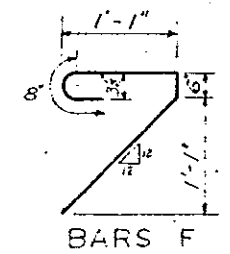


BARS F

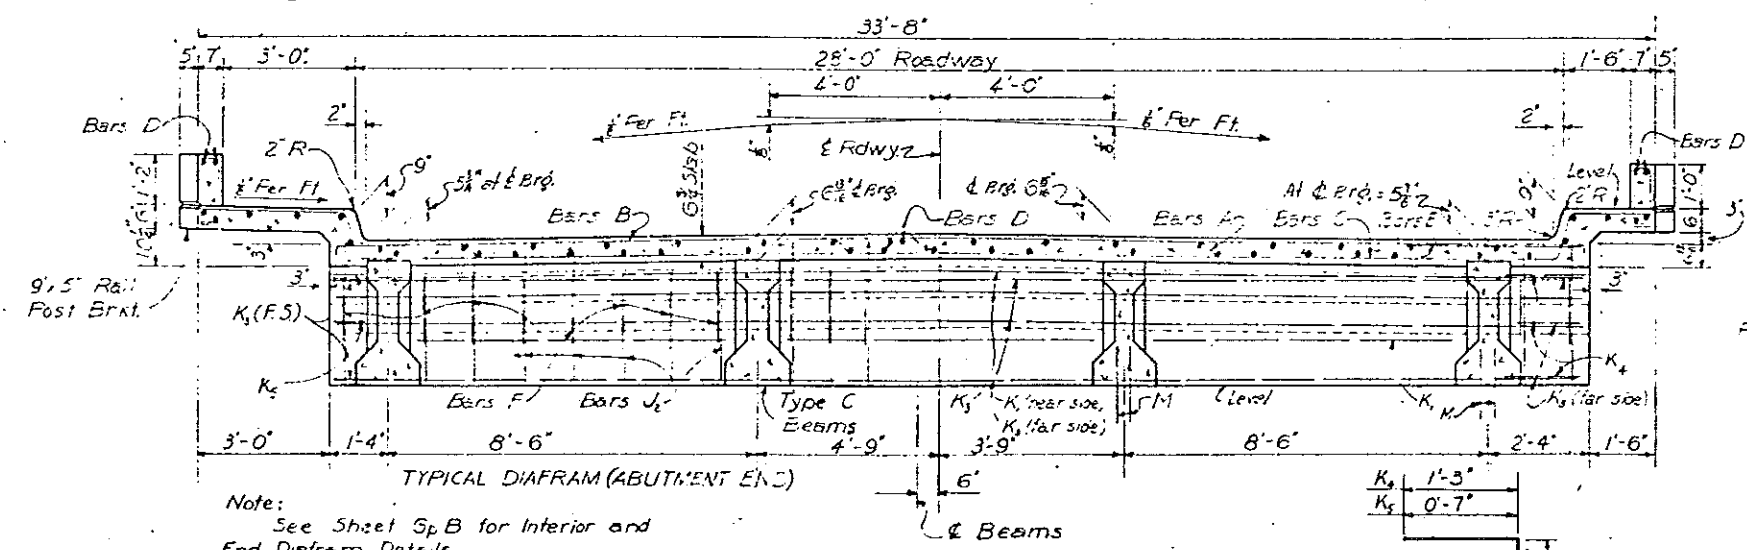

Note: See Sheet Sp B for Interior and End Diaphragm Details. All diaphragms shall be cast-in-place and shall be placed a minimum of 48 hours before the slab is placed.

TRANSVERSE SECTION A-A

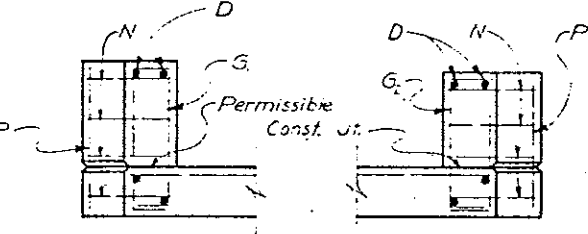

CONTRACTING NO. DA-1-240 CIVENG
MAR. 1958

Bar No	Size	Spacing	Length	Weight	
A	29	#5	1'-0"	15.7	
B	50	#5	1'-0"	15.6	
C	50	#5	1'-0"	15.29	
D	51	#5	Shown	52'-9"	280.6
E	3	#6	6'	2'-4"	3.9
G	54	#4	Shown	3'-10"	13.8
S ₂	54	#4	Shown	3'-6"	12.6
J	21	#4	1'-0"	5'-10"	8.2
J	42	#4	1'-0"	5'-2"	14.5
K ₁	24	#5	~	7'-2"	17.9
K ₂	4	#5	~	26'-3"	11.0
L	1	#0	~	26'-5"	11.4
F/A	12	#6	~	6'	4.5
N	48	#2	2'-5"	3'-5"	9.6
P	24	#4	0'-5"	1'-5"	2.0
Total Weight				877.4	

* Dowel Bars - Not performed. Average per span

Item	Unit	Quantity
Concrete, Class A	Cu. Yd.	45.0
Reinforcing Steel	Lbs.	577.4
Fresh Conc. Bms (Type C)	Lb.	209.33
Reinforcing Steel (Type C)	Lb.	12.6
Structural Steel (Type C)	Lb.	243

* Does not include quan. in prestressed concrete beams.
* Spans adjacent to R. Girder require two armor Rs.


Bar No	Size	Spacing	Length	Weight
F	24	#4	1'-0"	5.9
J ₁	21	#4	1'-0"	14.2
K ₁	5	#5	~	15.1
K ₂	3	#5	~	9
K ₃	2	#5	~	4
J	21	#4	Omit 2 Bars	-7.2
K ₂	2	#5	Omit 2 Bars	-5.5
K ₃	3	#5	~	2.2
Total				2.60

Item	Unit	Quantity
Concrete, Class A	Cu. Yd.	1.9
Reinforcing Steel	Lbs.	2.60

General Notes:
All cast-in-place concrete shall be Class A. Chamfer all exposed corners 1/4" unless otherwise noted.
All dimensions relating to reinforcing steel are to centers of bars.
Design stress for reinforcing steel = 20,000 psi.
Concrete surfaces shall be finished in accordance with Par. 402.24, Type 2 Surface Finish of specifications.

TEXAS HIGHWAY DEPARTMENT
53'-0" PRESTRESSED CONCRETE BEAM SPAN
26'-0" RDWY. 3'-0" SDV.L.K. 1" CURB
H20 LOADING








DATE	DESCRIPTION	DATE	BY	PROJECT NO.	SHEET
DEC 1957	DESIGN	FEB 1958	ADD #2 5/8"	11	11
CONTRACTING NO. DA-1-240 CIVENG MAR. 1958					

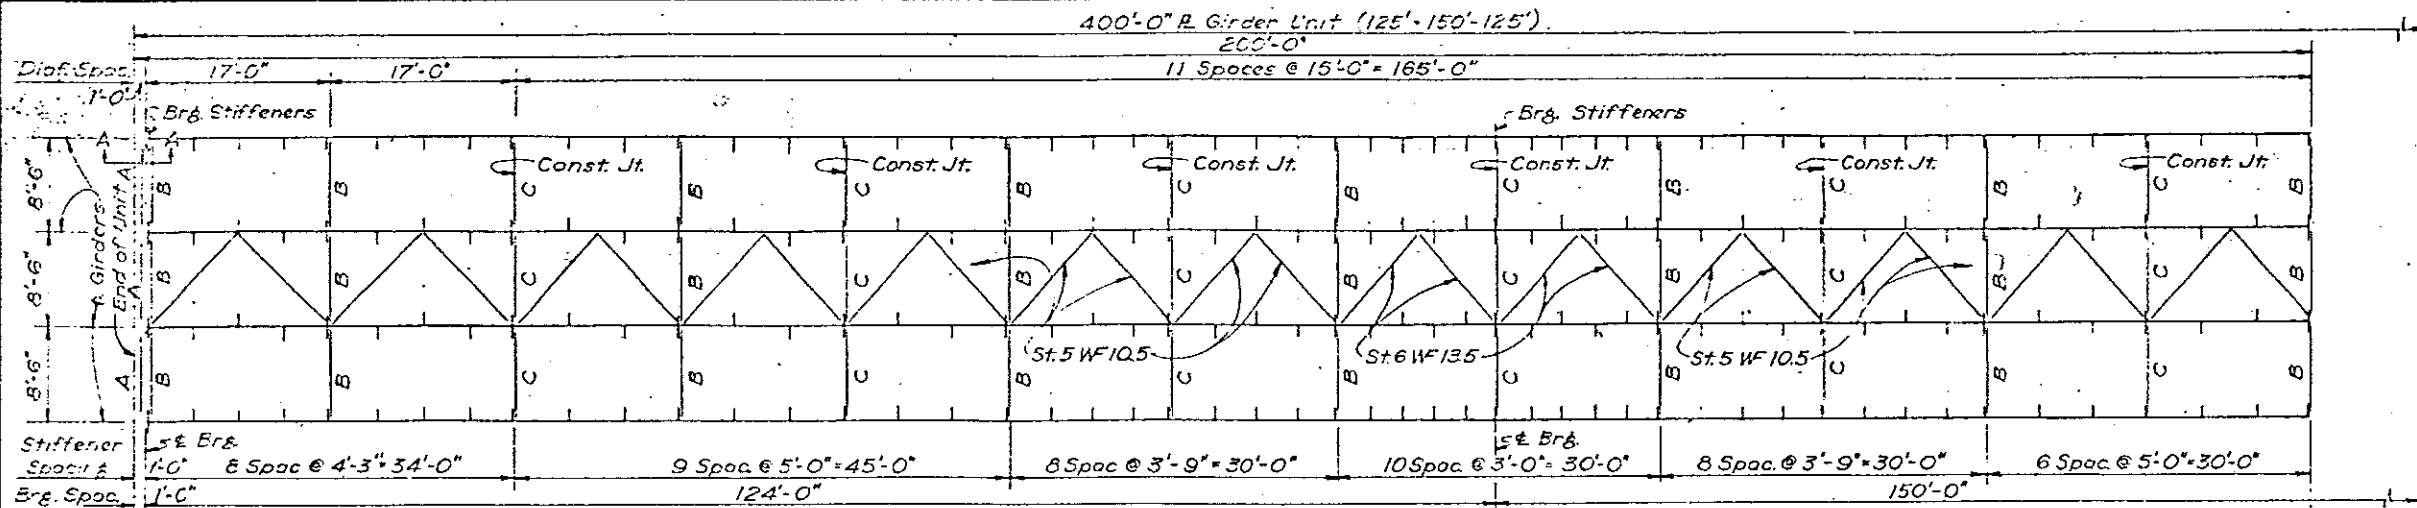

Bar	Size	Quantity	Weight (Lbs)
A	3/4"	12	61
B	3/4"	12	61
C	3/4"	12	61
D	3/4"	12	61
E	3/4"	12	61
F	3/4"	12	61
G	3/4"	12	61
H	3/4"	12	61
J	3/4"	12	61
Total lbs.			62270

Item	Unit	Quantity
Class A Concrete	Cu Yd	313.5
Reinforcing Steel	Lb	62270
Structural Steel	Lb	45510
Rolling	Sq Ft	800

Includes 670# for 2 Armor Rs. & 7440# for shoes.

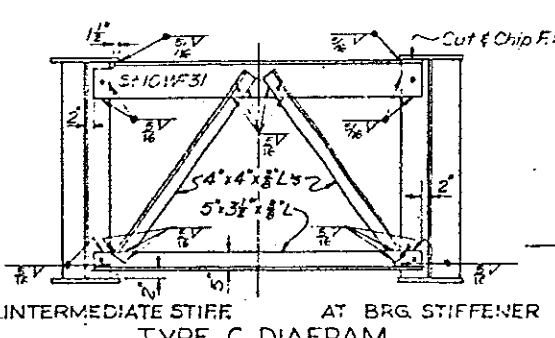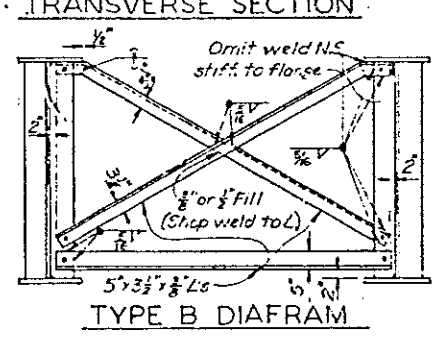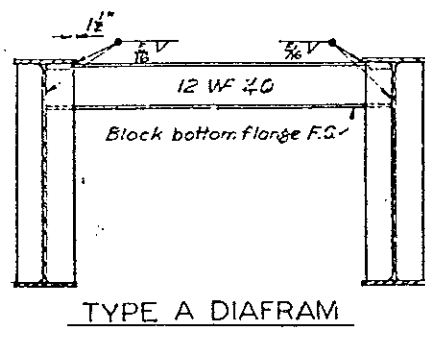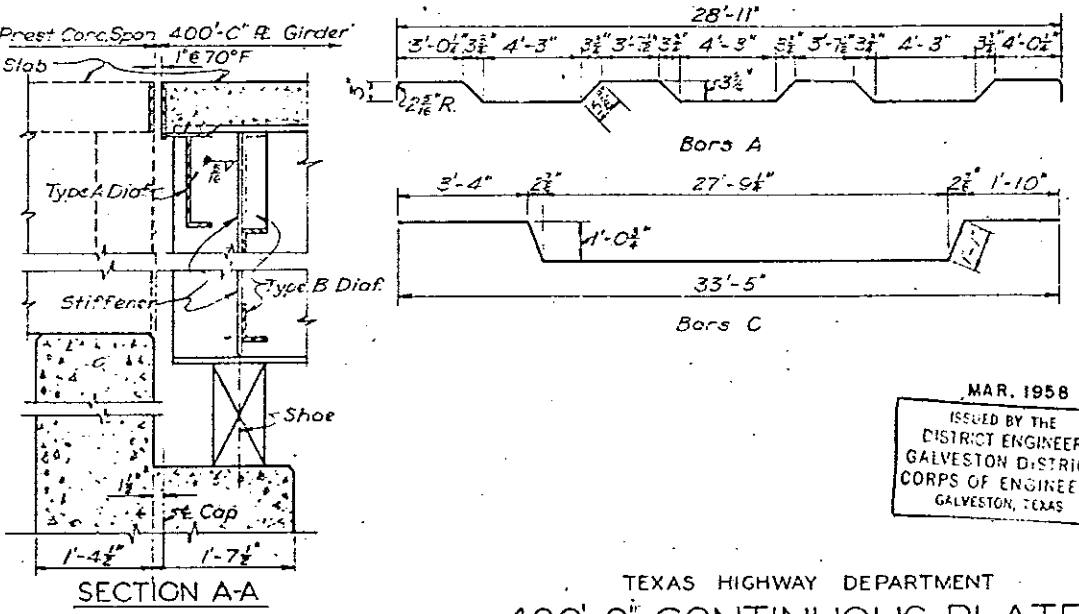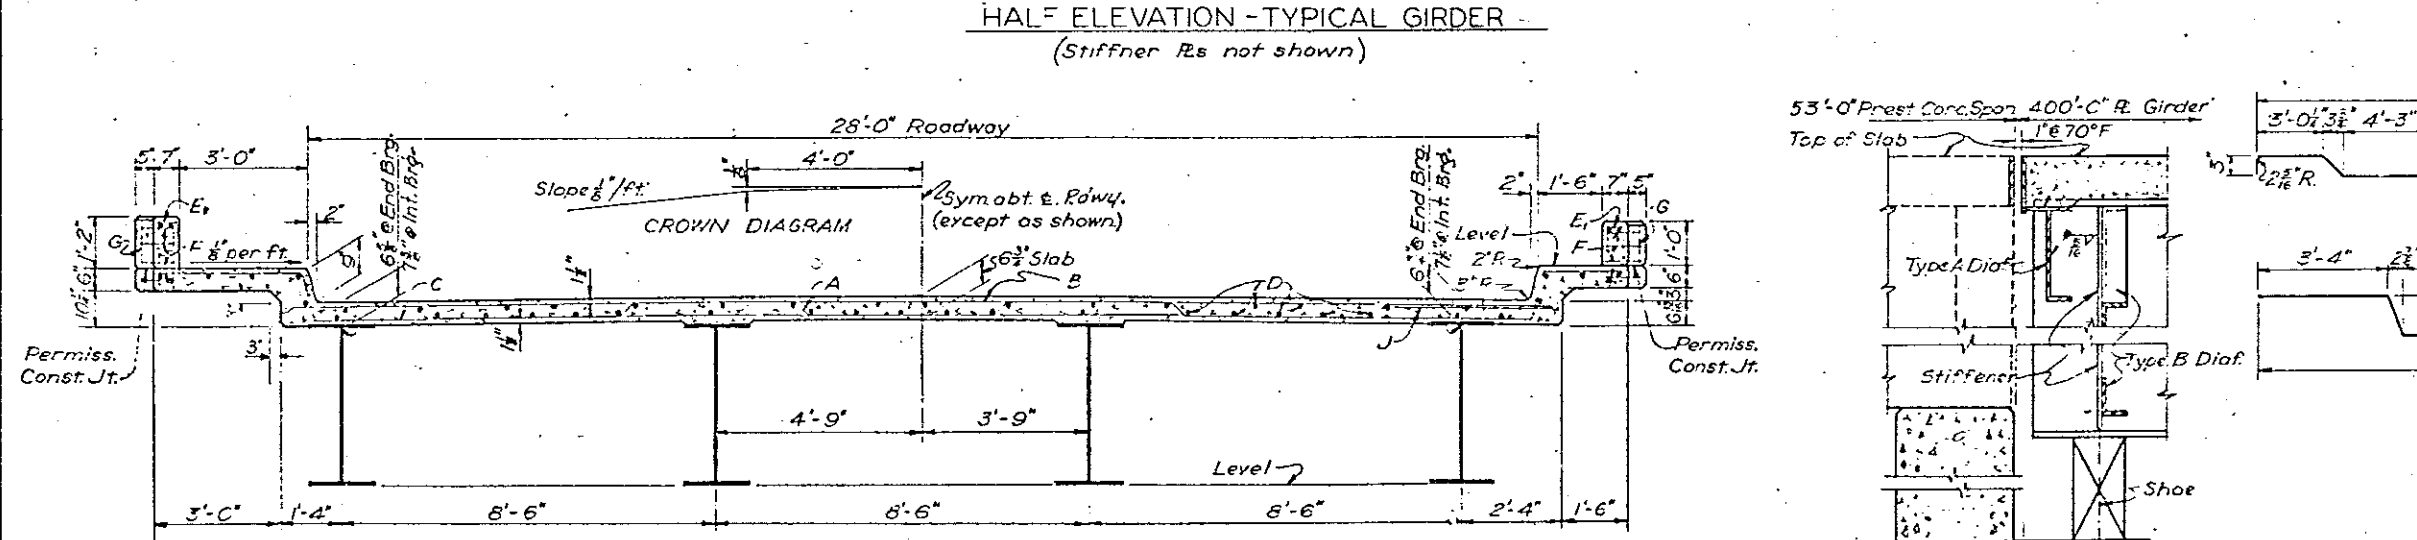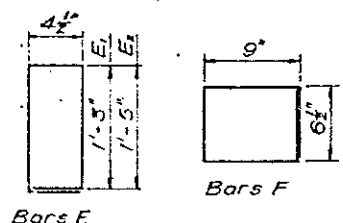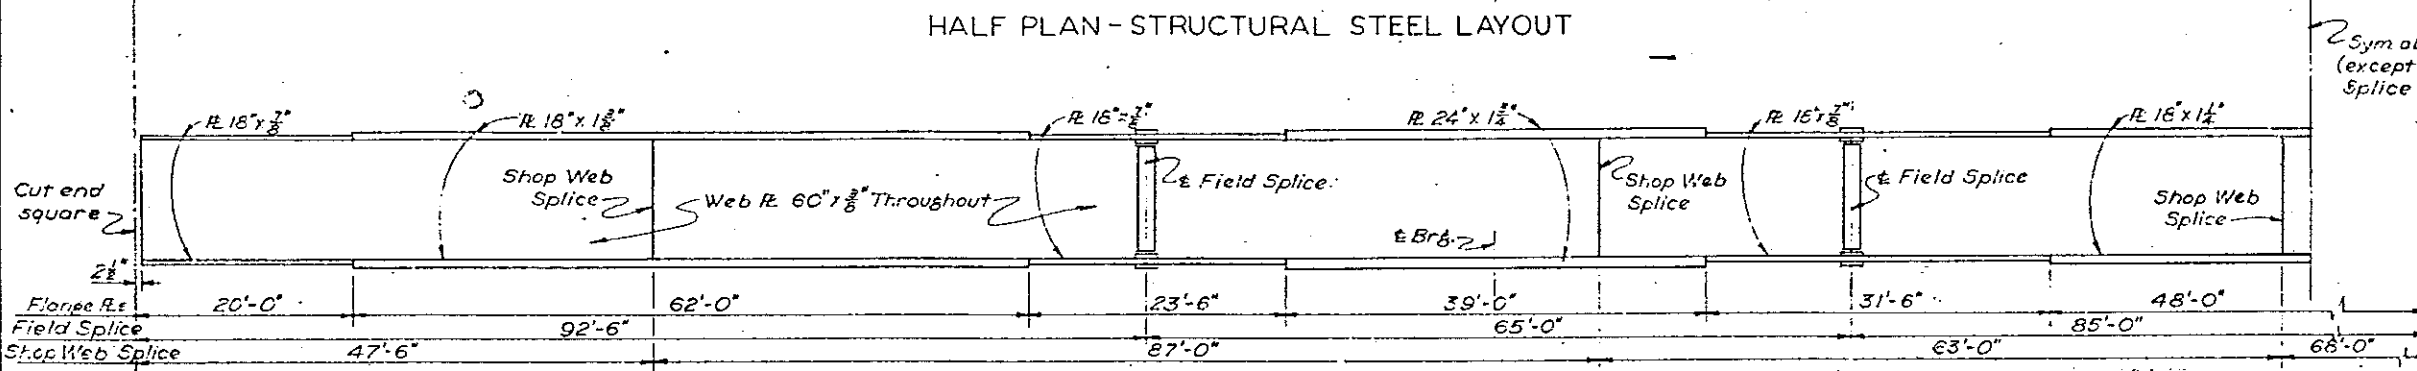

DIAFRAM DETAILS

Diagram Note:
At the option of the Contractor, the Fabricator may provide 1/2" diameter holes in the diaframs as shown. Such holes may be left open after field welding of diaframs.



CONTRACT NO. DA-41-243-CIVENG. 58-154

TEXAS HIGHWAY DEPARTMENT
400'-0" CONTINUOUS PLATE GIRDER UNIT
28'-0" RDWY. 36" SIDEWALK 18" CURB
GULF INTRACOASTAL WATERWAY BRIDGE

Sheet 1 of 4

DATE	BY	CHK'D	DATE	BY	CHK'D
DEC 1957

MAR. 1958
ISSUED BY THE DISTRICT ENGINEER GALVESTON DISTRICT CORPS OF ENGINEERS GALVESTON, TEXAS

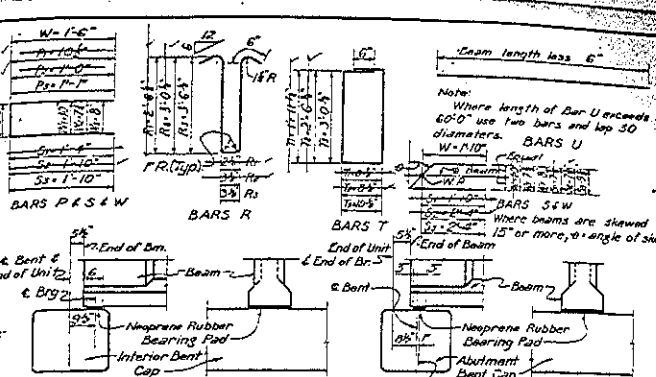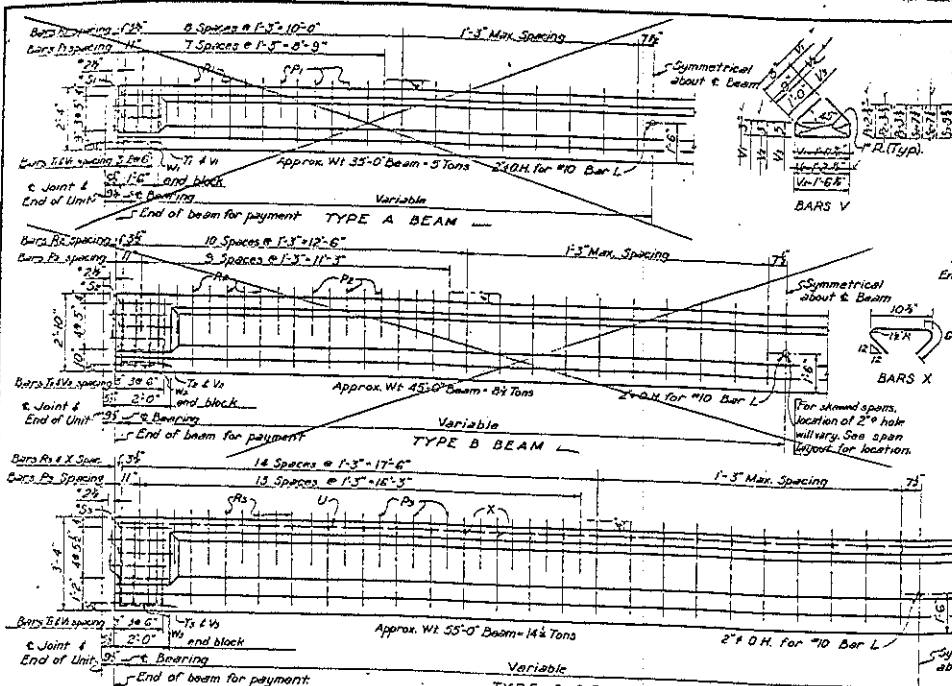

BEARING SEAT DETAILS

Note: Prestressed Concrete Beams shall be seated on neoprene synthetic rubber pads of 70 durometer hardness, 6" wide and a length equal to the normal width of the bottom flange of the beam. Beams to be erected on grade in excess of 1% shall have ends beveled as shown below. The thickness of the rubber pad shall vary with the slope of the erected beam as follows:

6% Grade & under - 3/4" Thick
 Increase thickness above that shown over 6% thru 8% Grade - 1" Thick
 1% Thick for each 10' of span over 60'.

Payment for furnishing and installing the neoprene bearing pads shall be included in the unit price bid for "Prestressed Concrete Beams".

Min. thickness as shown above (1" or 1 1/2")

BILL OF REINFORCING STEEL - ONE BEAM ONLY




Bar #	Size	Quantity	Weight
TYPE A BEAM - 35'-0" SPAN			
U	2	2	11.2
S	2	2	11.2
T	2	2	11.2
V	2	2	11.2
W	2	2	11.2
X	2	2	11.2
TYPE B BEAM - 45'-0" SPAN			
U	2	2	11.2
S	2	2	11.2
T	2	2	11.2
V	2	2	11.2
W	2	2	11.2
X	2	2	11.2
TYPE C BEAM - 55'-0" SPAN			
U	2	2	11.2
S	2	2	11.2
T	2	2	11.2
V	2	2	11.2
W	2	2	11.2
X	2	2	11.2

DIMENSIONS FOR LIFTING EYE

Beam Type	Span	Concrete	Reinforcing Steel	Prestressing Steel	For Each Additional Foot
A	35'-0"	250	150	246	0.071
B	45'-0"	410	290	415	0.093
C	55'-0"	104	550	670	0.127

HALF ELEVATIONS

NOTE: Prestressing strands shall extend 3' beyond ends of all Beams.

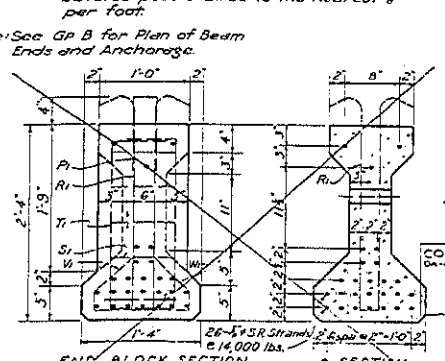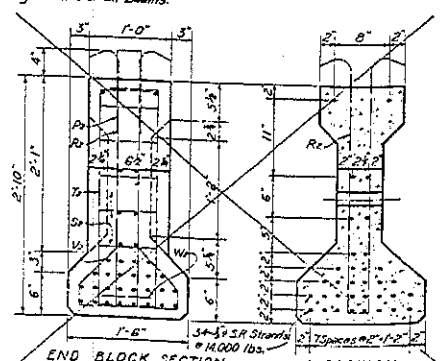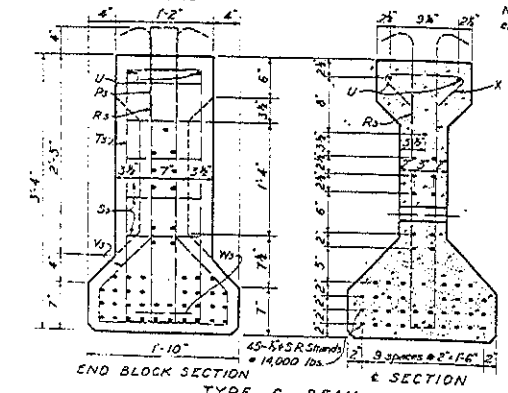

BEAMS ON GRADE IN EXCESS OF 1%

Note: Dimensions, match marks and locations of each pad must be clearly shown on the Contractor's Shop Plans. Bevel of beam or beveled pads shall be to the nearest 1/4" per foot.

Note: See Gp B for Plan of Beam Ends and Anchorage.

GENERAL NOTES:

All concrete shall be Class F. See specifications.

Chamfer all exposed corners if unless otherwise noted. Exposed corners of beams may be rounded to 4 radius in lieu of chamfering.

Dimensions relating to reinforcing steel and prestressing strands are to centers of bars or strands.

Variable holes or anchorage devices for supporting forms for cast-in-place concrete may be cast in beams at the option of the Contractor, provided they are indicated on the working drawings and approved by the Engineer.

Tips of beams shall be rough finished, as approximately the time of initial set, entire top of beam shall be scrubbed transversely with coarse wire brush to remove all laitance and to produce a roughened surface for bonding slab.

In the handling of beams, they must be maintained in an upright position at all times and must be picked up from points within the web bearing blocks at the beam ends. Caregiver of this requirement may lead to collapse of the member.

Concrete surfaces shall be finished in accordance with Par. 402.24, Type 2 Surface Finish of specifications.

MAR 1955



CONTRACT NO. DA-41-240 CIVDING
 58-134 TEXAS HIGHWAY DEPARTMENT

PRESTRESSED CONC. BEAMS


Gp A

Bar #	Size	Quantity	Weight
U	2	2	11.2
S	2	2	11.2
T	2	2	11.2
V	2	2	11.2
W	2	2	11.2
X	2	2	11.2


NOTE: All cast-in-place diaphragms shall be cast before pouring of the roadway slab. After the concrete has obtained a minimum compressive strength of 1500 psi, the nuts of the #10 bar shall be firmly tightened.

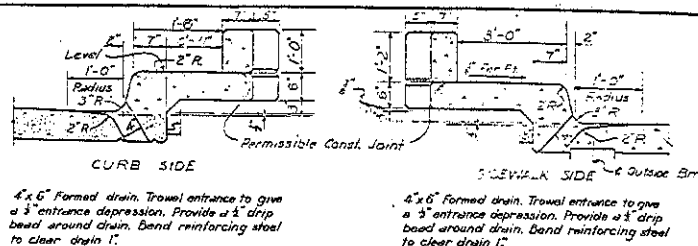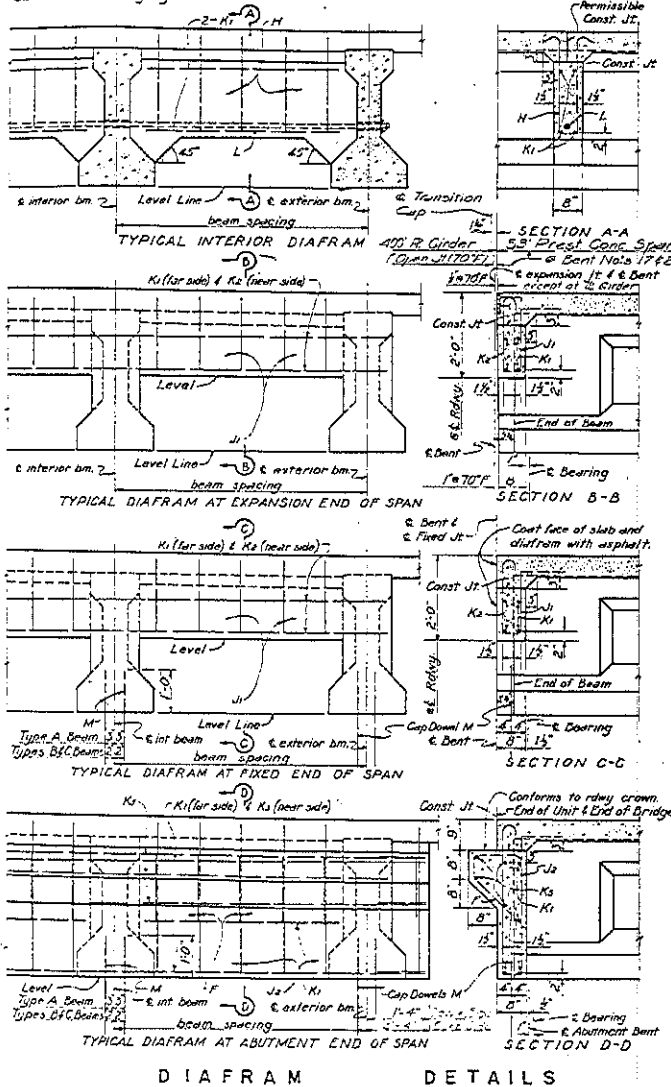


CURB & DRAIN DETAILS

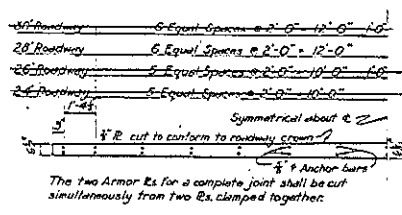

ARMORED JOINT DETAILS

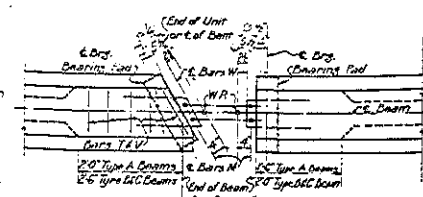

PLAN OF BEAM ENDS AND ANCHORAGE

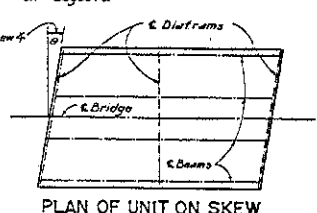

NOTES:
 Areas of unreinforced concrete in contact with bent cap shall be placed on a layer of 3" Preformed Bituminous Fiber Material, THD Spec 4022, Type III.
 Part of dowel bar M to be embedded in diaphragm shall be wrapped with layers of 1/2" asphalt roofing felt, top of dowel capped with sheet metal cap containing 2" paper cushion.

GENERAL NOTES:
 All cast-in-place concrete shall be Class A. Chamber all exposed corners 3" unless otherwise noted.
 All dimensions relating to reinforcing steel are to centers of bars.
 Design stress for reinforcing steel = 20,000 psi.
 Concrete surfaces shall be finished in accordance with Par. 402.24, Type 2 Surface Finish of specifications.


TEXAS HIGHWAY DEPARTMENT
PRESTRESSED CONCRETE BEAM SPAN DETAILS
 Gp B

CONTRACT NO. SR-154
 DATE: 1956


BUILT BY THE DISTRICT ENGINEER, CALVESTON DISTRICT, CORPUS OF ENGINEERS, CALVESTON, TEXAS

NO.	DATE	BY	REVISION
1			
2			
3			
4			
5			
6			
7			
8			
9			
10			


AS BUILT
 GALV. DIST. FILE NO. TRW 1150-599

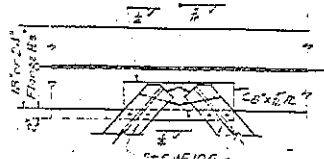


CONNECTION BETWEEN DIAFRAMS

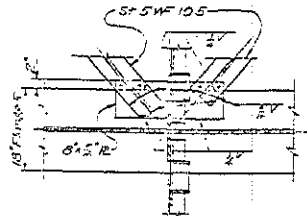


CONNECTION AT DIAFRAM TYPES B & C

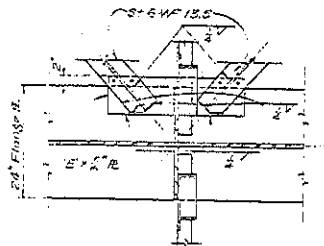

CONNECTION AT INTERIOR BEARINGS

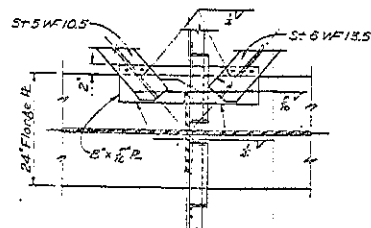


CONNECTION AT DIAFRAM TYPE B

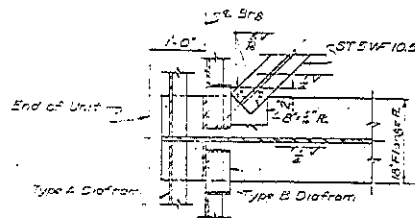

CONNECTION AT END BEARINGS


BOTTOM LATERAL SYSTEM

Note: At the option of Contractor the Fabricator may provide 1/2" erection holes in the lateral connections such holes may be left open after field welding of laterals.

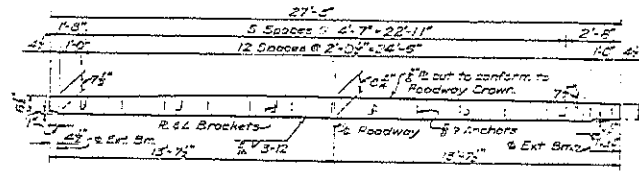


ELEVATION

Note: Field weld angles to top flange of diafram, adjust Armor B to correct grade & alignment & bolt for field welding. The two Armor Bs for a complete joint shall be cut simultaneously from two Re slabs together. Armor Bs. may be shipped in convenient lengths and field butt welded.

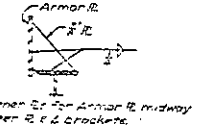

SECTION

ARMOR JOINT DETAILS

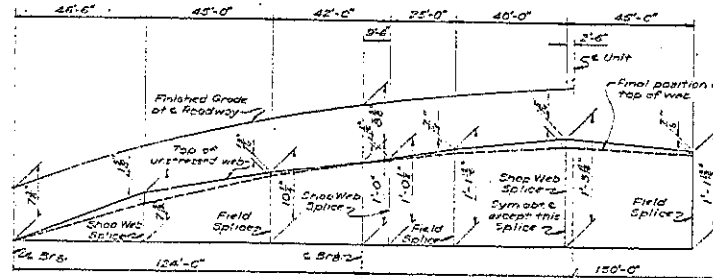

GIRDER BLOCKING DIAGRAM

Assembled undeformed position of girder is to compensate for vertical curve and for a dead load of 1000' per girder.

TEXAS HIGHWAY DEPARTMENT
400'-0" CONTINUOUS PLATE GIRDER UNIT
 28'-0" RDWY. 36" SIDEWALK 18" CURB
 GULF INTRACOASTAL WATERWAY BRIDGE

CONTRACT NO. GALV-125-GVING.
 38-154

MAR. 1958

DESIGNED BY THE
 DISTRICT ENGINEER
 DIVISION DISTRICT
 CORPS OF ENGINEERS
 GALVESTON TEXAS

Sheet 2 of 4


NO.	DATE	BY	FOR	REVISION
1				
2				
3				
4				

AS BUILT


GALV. DIST. FILE NO. IWW 1100-589

1" Sp. @ 1'-0" - 3'-0" T/c. Spac. Bars E, & E₁


Typ. S₁

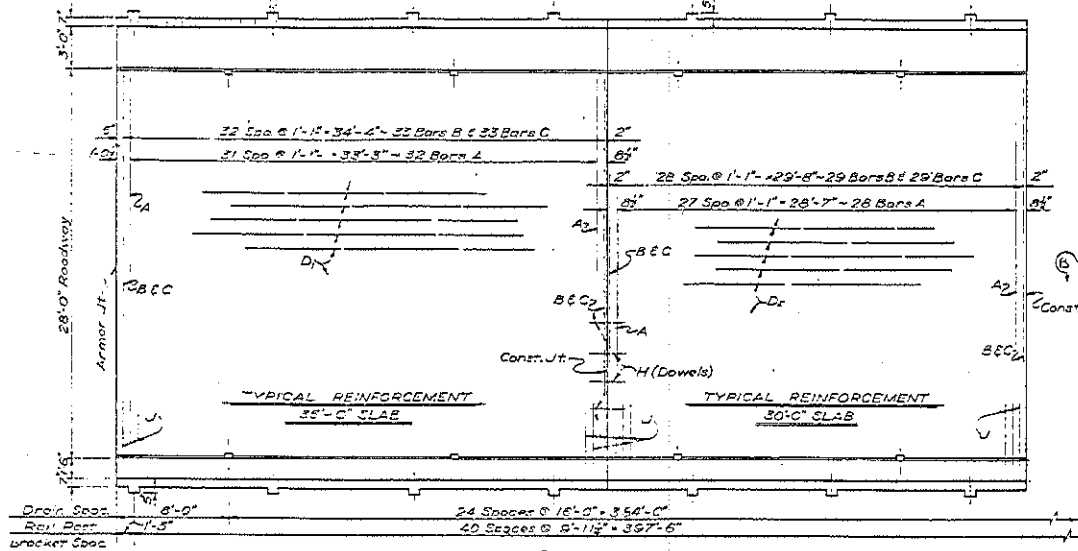

PLAN
TYPICAL SLABS

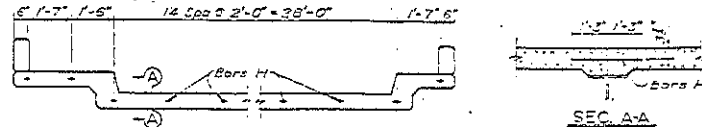


LOCATION OF DOWEL BARS H
AT CONSTRUCTION JOINTS

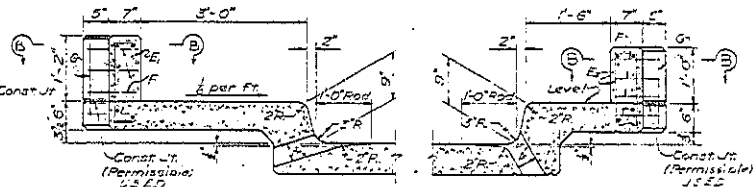


SIDEWALK & DRAIN DETAIL

CURB & DRAIN DETAIL

4" x 6" Formed Drain, Trowel Entrance to give a 1/2" entrance depression. Provide a 1/2" drip bead around drain. Bend reinforcing steel to clear drain 1".

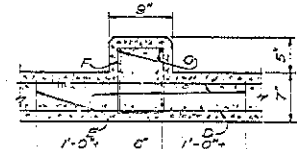


SEC. B-B

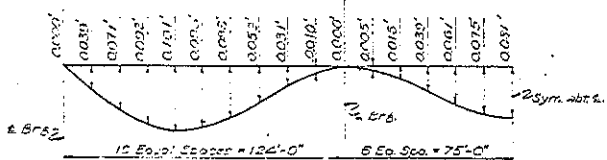

DEAD LOAD DEFLECTION DIAGRAM
(Due to Conc. & Rail Only)

CONSTRUCTION PROCEDURE: Allow all structural steel to settle on accurate measurements shall be made of the beam. Tolerances of all control corners. Subsequent setting of forms, piers and finishing of concrete shall be governed by these measurements only, taking into account the deflections shown above.

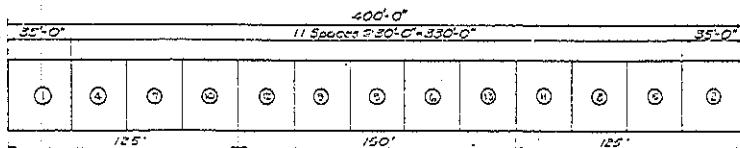

SLAB POURING SEQUENCE

CONTRACT NO.
SR-154











AS BUILT

MAR 1956
DESIGNED BY THE
STATE ENGINEER
GALVESTON DISTRICT
CORPS OF ENGINEERS
GALVESTON, TEXAS


TEXAS HIGHWAY DEPARTMENT
400'-0" CONTINUOUS PLATE
GIRDER UNIT
28'-0" RDWY. 38" SIDEWALK 18" CURB
GULF INTRACOASTAL WATERWAY BRIDGE

NO.	DATE	BY	FOR	REVISION
1				
2				
3				
4				
5				
6				
7				
8				
9				
10				
11				


GALV. DIST. FILE NO. IWW 1150-599

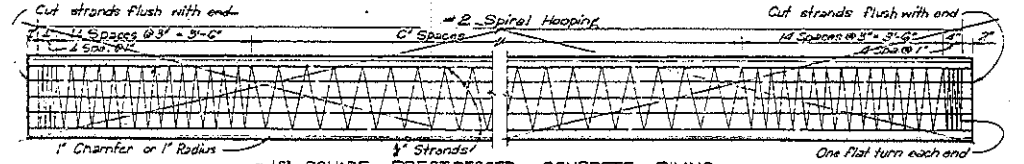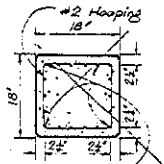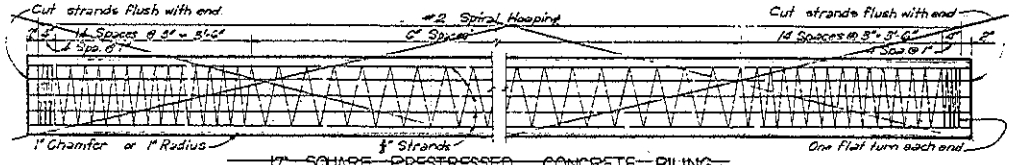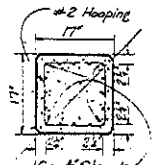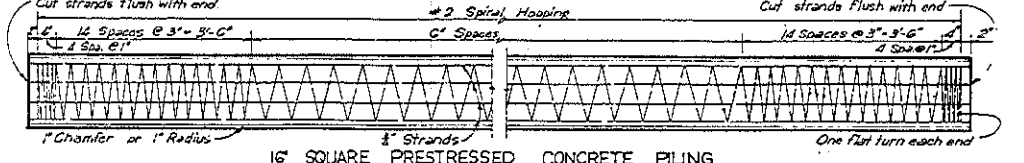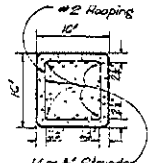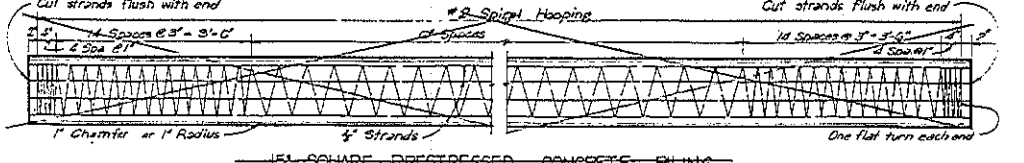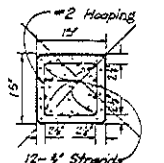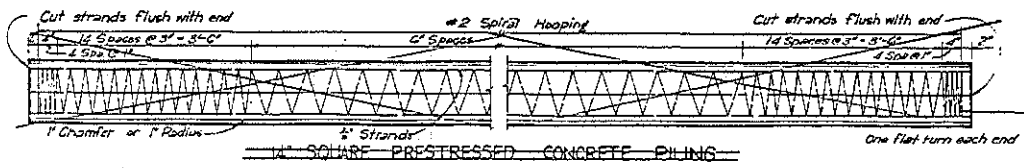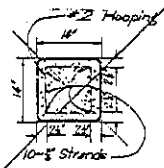


Pile Size	Number
14"	10
15"	12
16"	14
17"	16
18"	18

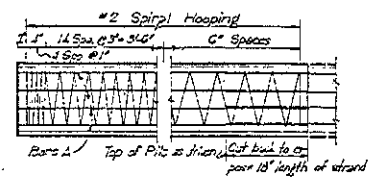

DETAIL OF BUILD-UP

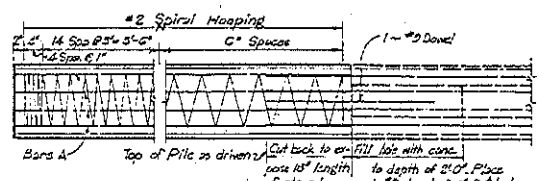


DETAIL OF BUILD-UP WITH OPTIONAL HOLE
Class A Concrete may be used for pile build-up when no additional driving is required.


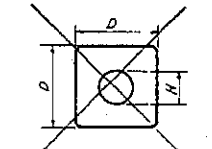


OPTIONAL FORMED HOLE
(Entire Length of Pile)

D	H	Strands
14	5	10
15	7	12
16	7	14
17	8	16
18	9	18

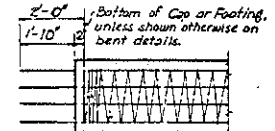

PILING AFTER DRIVING (SPECIAL)
(See note at right)

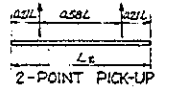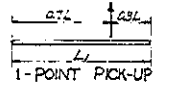

Reinforcing steel shall protrude into sub-structure concrete only where shown in sub-structure details in which case piles may be cast to approved length with reinforcing steel protruding from top of pile, or piles may be cast to extra length and cut back after driving to expose reinforcing steel.
Cost of reinforcement projecting into caps or footings shall be included in price bid for Piles.

Pick-up lengths are based on careful handling and on holding pile firmly in this position (horiz.) throughout all lifting or handling, if the pile at any time assumes this position (diag.), reduce allowable lengths by 15%.


TABLE OF ELEMENTS

Pile Size	Area	# Strands	Ic	L1	L2
In.	Sq. In.	No.	In ⁴	Ft.	Ft.
14	154.5	10	374	25	77
15	225	12	504	30	90
16	256	14	616	35	105
17	289	16	729	40	120
18	324	18	864	45	135

GENERAL NOTES:
All concrete shall be Class F except as noted. All corners shall be chamfered as shown or noted.
All dimensions relating to reinforcing steel are to centers of bars or strand.
Size, number and length of piling shall be as shown on Layout Sheet.
All strands shall be initially prestressed to 14,000 lbs./strand.
Concrete surfaces shall be finished in accordance with Par. 402.24, Type 2 Surface Finish of specifications.

TEXAS STATE HIGHWAY DEPARTMENT
PILING
PRESTRESSED CONCRETE
PP-1


MAR. 1958
DESIGNED BY THE DISTRICT ENGINEER GALVESTON DISTRICT CORPS OF ENGINEERS GALVESTON, TEXAS
CONTRACT NO. DA-41-243-GVNH-58-154
GALV. DIST. FILE NO. 11W 1150-599

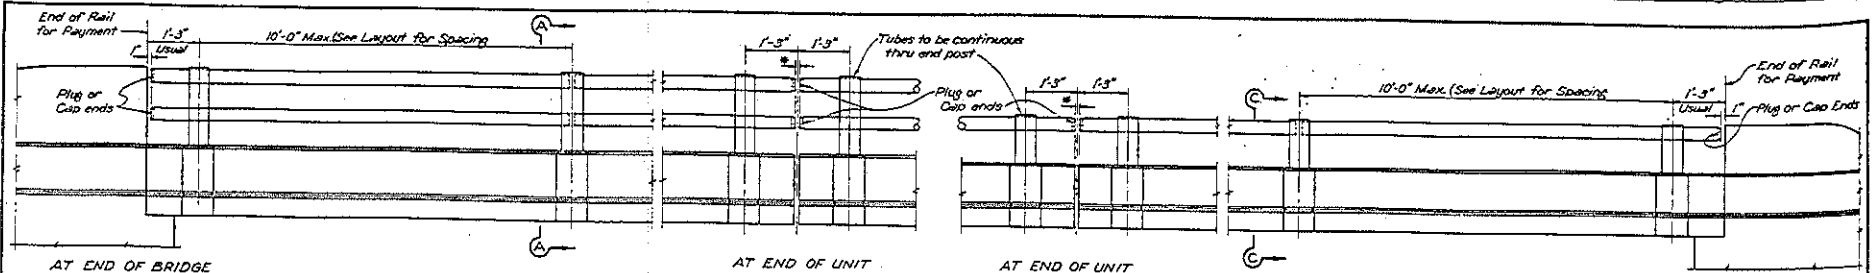

ELEVATION - PEDESTRIAN RAILING

ELEVATION - TRAFFIC RAILING


* 2" for rail members * Fixed joint. Provide opening 8" wider than normal joint opening in slab * exp. joint.

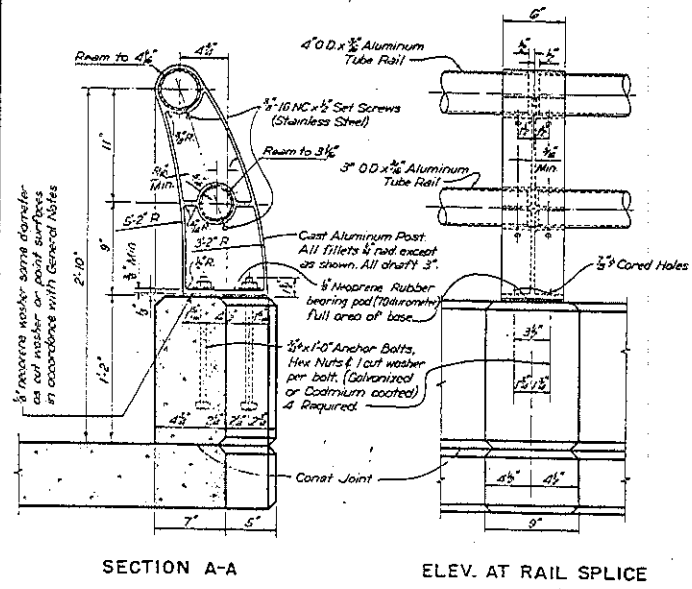

SECTION A-A

ELEV. AT RAIL SPLICE

ALUMINUM RAILING
PEDESTRIAN
(TYPE P)

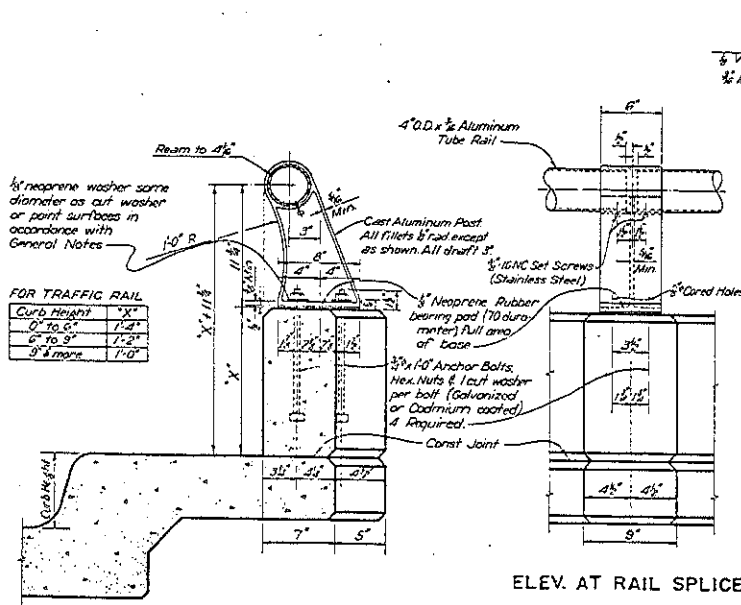


FOR TRAFFIC RAIL

Curb Height	"X"
0" to 6"	1'-2"
6" to 9"	1'-2 1/2"
9" & more	1'-0"

SECTION C-C

ALUMINUM RAILING
TRAFFIC
(TYPE T)

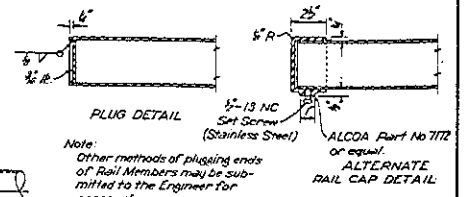

RAIL END DETAILS

GENERAL NOTES:
 All anchorage provisions are considered as parts of the railing for payment.
 Rail sections may be made continuous for as many as 3 post spaces.
 All parts of the railing except anchor bolts, nuts & washers shall be made from Aluminum Alloy; see Special Provision.
 Anchor Bolts and Nuts shall be Cadmium coated by the Uylite Process in accordance with A.S.T.M. Spec. A-153 or Galvanized in accordance with A.S.T.M. Spec. A-153.
 Rail tubing shall be bent to follow curvature of roadway. Posts and Post Brackets to be vertical.
 All surfaces of Anchor Bolts, Nuts or washers coming in contact with Post shall be thoroughly coated with an aluminum impregnated caulking compound or a neoprene rubber gasket will be used.
 Welding shall be done by an arc welding process in which no welding flux is used. Welding is not permitted except as shown.

TEXAS HIGHWAY DEPARTMENT
ALUMINUM RAILING
TYPES P & T

CONTRACT NO.
DA-41-243-GIVEND
88-154

MAN. 1958

ISSUED BY THE DISTRICT ENGINEER GALVESTON DISTRICT CORPS OF ENGINEERS GALVESTON, TEXAS

NO.	DATE	BY	REVISION
1			
2			
3			
4			
5			

AS BUILT GALV. DIST. FILE NO. 11W 1130-509