



COUNTY & STATE	HARRIS COUNTY, TEXAS									
TERRAIN	FLAT BLACK LAND									
OWNERSHIP	81+16	J.F. ROBINSON, EST.	90+18	U.S. HIGHWAY 288 R/W	101+31	J.F. ROBINSON, EST.	114+96	W. H. ROACH EST.	121+95	MINNETEX PLACE
RODS		175.76		25.15		42.42		20.87		44.18

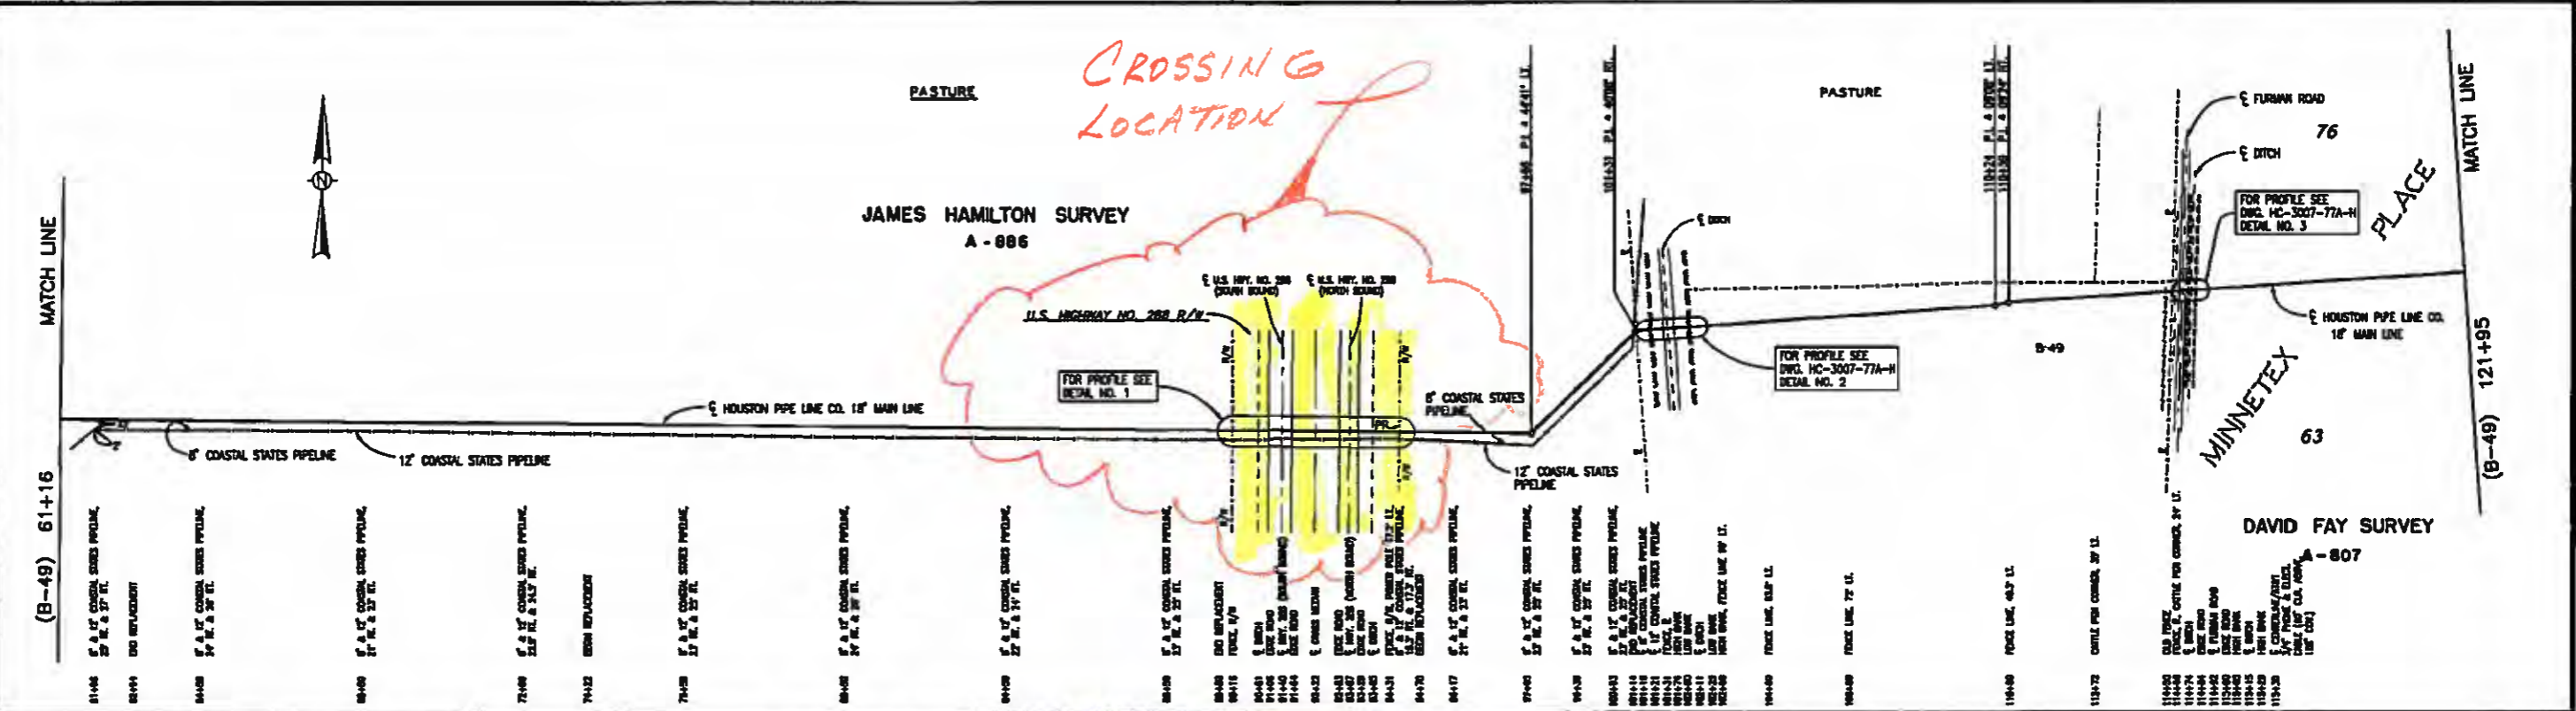

MATERIAL	81+15	178'-10\"/>
----------	-------	-------------

ITEM NO.	QUAN.	DESCRIPTION
PROPERTY UNIT NO. 356-10		
1	1,128'	18\"/>
2	2,561'	18\"/>
3	0	18\"/>
4	2,300'	18\"/>
5		
PROPERTY UNIT NO. 356-15		
6	424'	18\"/>
7	2	18\"/>
8	20	18\"/>
9	22'-0\"/>	
10	2	18\"/>

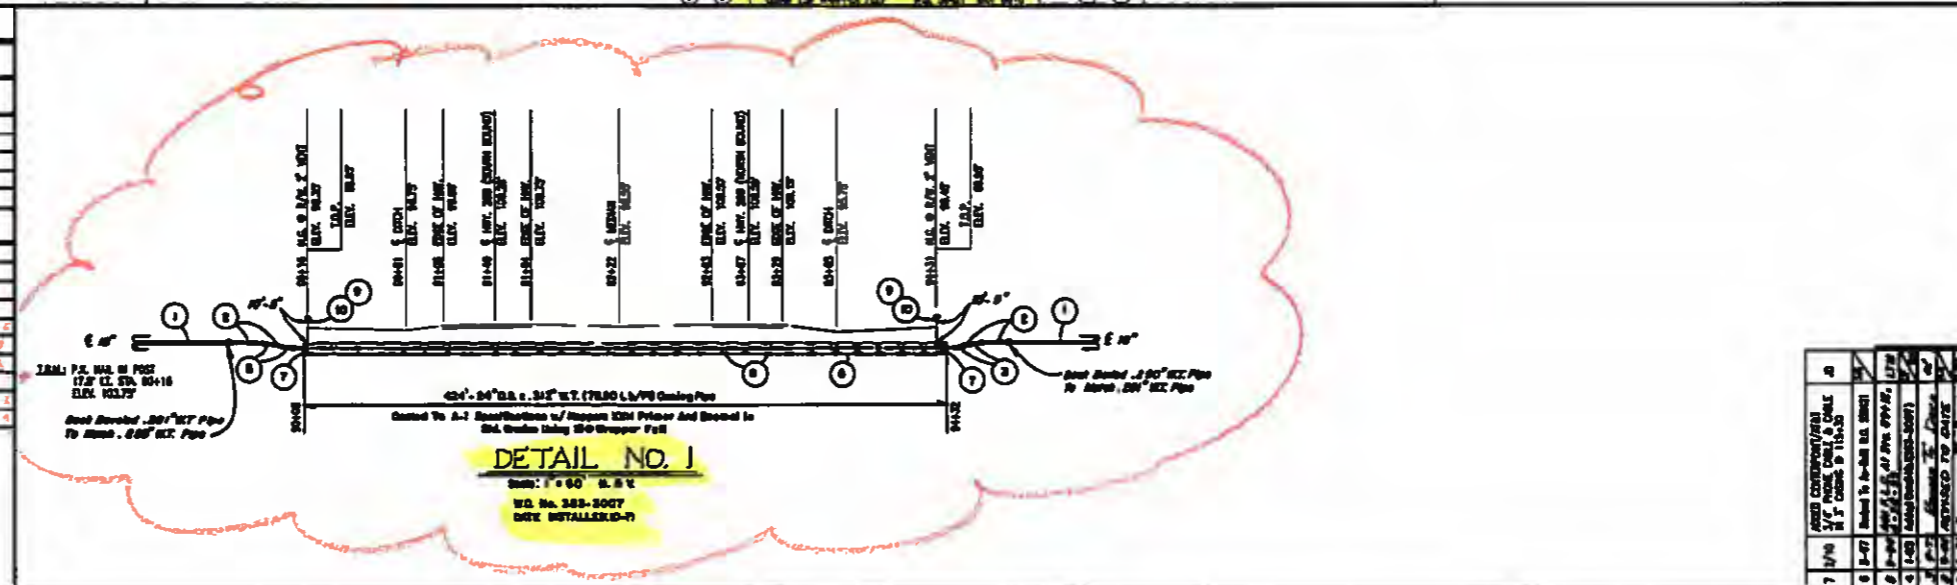

PREVIOUS DWG. NO. HC-105-1099

FOR PREVIOUS REVISION SEE "CLOSEST" EDMSION DOC. # 2266126

As-Built Field Book No. 6069	Page 14
As-Built Field Book No. 6041	Pages 7-8
As-Built Field Book No. 6068	Pages 4-6

REFERENCE DRAWINGS

HOUSTON PIPE LINE COMPANY
ENGINEERING DEPARTMENT - HOUSTON, TEXAS

EDNA - IND. JCT. 18\"/>